


CERTIFIED RECORD OF LAND CORNER MONUMENTATION

HISTORY OF ORIGINAL CORNER ESTABLISHMENT:

Corner originally established by Jeff Petersen in Survey Number 11-41-15, as filed in the office of the Baker County Surveyor. Monumentation record states:

Set a 2 1/2" x 30" aluminum pipe with aluminum cap, 24 inches in the ground, from which:

- A 15 inch White Fir bears N72°E, 54.25 feet marked C 1/4 S20 BT.
- A 9 inch Douglas Fir bears S23°E, 63.18 feet marked C 1/4 S20 BT.
- A 20 inch Ponderosa Pine bears S29°W, 84.60 feet marked XT BT.
- A 20 inch Ponderosa Pine bears N78°W, 8.19 feet marked C 1/4 S20 BT.

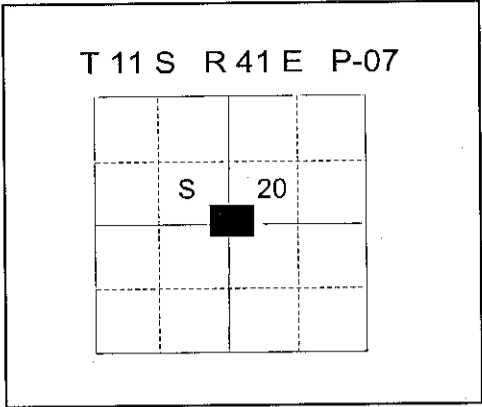

DESCRIPTION OF CORNER EVIDENCE FOUND:


Found 2 1/2" aluminum pipe with 2 1/2" Aluminum cap marked as shown below, set flush with the ground in mound of stone 1.5 ft. diam., from which:

- A 19 inch White Fir bears North 72° East, a distance of 54.25 feet, with visible scribe marks on partially healed blaze.
- A 13 inch Douglas Fir bears South 23° East, a distance of 63.18 feet, with fully healed blaze.
- A 21 inch Ponderosa Pine bears South 29° West, a distance of 84.60 feet, with visible scribe marks on partially healed blaze.
- A 22 inch Ponderosa Pine bears North 78° West, a distance of 8.19 feet, with visible scribe marks on partially healed blaze.

DESCRIPTION OF MONUMENT AND ACCESSORIES I ESTABLISHED TO PERPETUATE THE ORIGINAL LOCATION OF THIS CORNER:

I hereby certify that the corner was perpetuated on July 2, 2009
Witness: Jeff Hsu, Gregory T. Blackman, Jr.

**REGISTERED
PROFESSIONAL
LAND SURVEYOR**

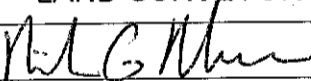

OREGON
July 17, 1986
RICK G. ROBINSON
2219

Renewal Date: December 31, 2010

T 11 S R 41 E
C 1/4
+

S 20
1994
OPLS 2625

I used a steel tape and magnetic compass in the measurement of the bearing trees. I used 18° East declination. The distance is to a 60d spike driven into the root crown at the right side of the bearing trees.