

CERTIFIED RECORD OF LAND CORNER MONUMENTATION

HISTORY OF ORIGINAL CORNER ESTABLISHMENT:

Originally established by Benjamin Vaughn under GLO Contract No. 211, dated July 14, 1874. Surveyor record states:


Set Stone 16x10x10 for 1/4 Sec. Cor.

Reestablished at proportionate position by C. Albert White under special instructions dated September 3, 1940, included under Group No. 261. Surveyor record states:

Set an iron post, 28 ins. long, 2 1/2 ins. diam., 24 ins. in the ground, from which:

A yellow pine 16 ins. diam., bears N. 69° E., 15 lks. dist., mkd. 1/4 S21 BT.

A yellow pine, 14 ins. diam., bears N. 22° W., 19 lks. dist., mkd. 1/4 S20 BT.

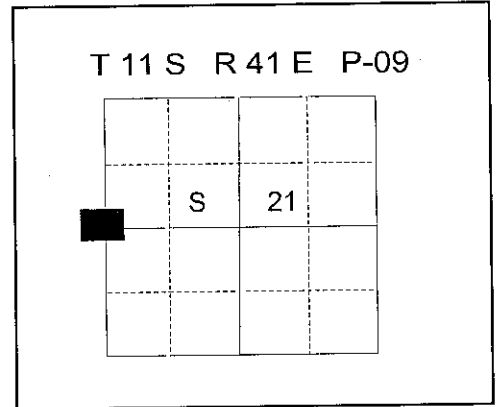

DESCRIPTION OF CORNER EVIDENCE FOUND:

Found Bureau of Land Management 3" Brass cap on 2 1/2" iron post, flush with the ground, from which:

An 18 in. Ponderosa Pine bears North 70° East, a distance of 10.21 feet, with fully healed blaze.

DESCRIPTION OF MONUMENT AND ACCESSORIES I ESTABLISHED

TO PERPETUATE THE ORIGINAL LOCATION OF THIS CORNER:

NEW BEARING TREES:

- A 12 in. Ponderosa Pine bears South 50° East, a distance of 38.09 feet, marked 1/4 S21 BT.
- An 8 in. Ponderosa Pine bears South 46° West, a distance of 27.49 feet, marked 1/4 S20 BT.
- A 17 in. Ponderosa Pine bears North 16° West, a distance of 36.60 feet, marked 1/4 S20 BT.


I place a steel fencepost 1 foot North of the corner monument and attach a Land Survey Monument sign.

I hereby certify that the corner was perpetuated on July 1, 2009
Witness: Jeff Hsu

REGISTERED
PROFESSIONAL
LAND SURVEYOR

Rick G. Robinson
OREGON
July 17, 1988
RICK G. ROBINSON
2219

Renewal Date: December 31, 2010

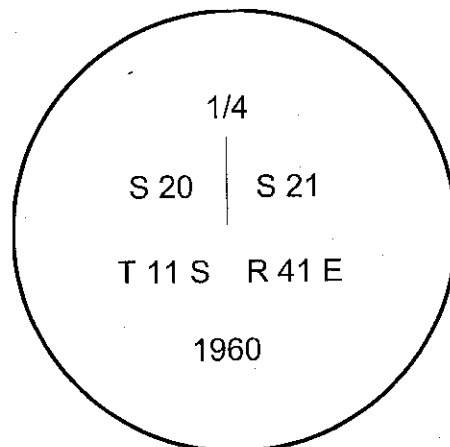

I used a steel tape and magnetic compass in the establishment of the bearing trees. I used 18° East declination. I attached a brass washer marked OPLS 2219 to the BT blaze. The distance is to a 60d spike driven into the root crown at the right side of the new bearing trees.