


CERTIFIED RECORD OF LAND CORNER MONUMENTATION

HISTORY OF ORIGINAL CORNER ESTABLISHMENT:

Corner not previously established.

DESCRIPTION OF CORNER EVIDENCE FOUND:

None

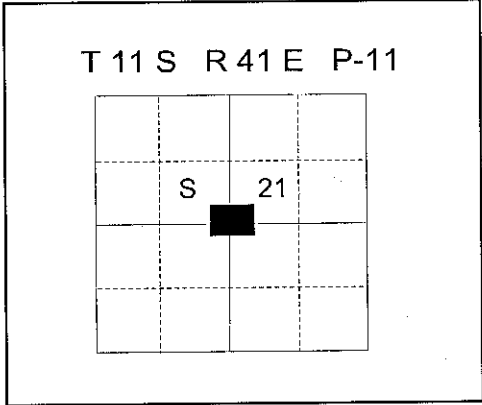

DESCRIPTION OF MONUMENT AND ACCESSORIES I ESTABLISHED

TO PERPETUATE THE ORIGINAL LOCATION OF THIS CORNER:

At position determined by survey, I set a USDA Forest Service 2 1/2" x 30" Aluminum pipe, with 3" aluminum cap marked as shown, 24" in the ground, from which:

- A 7" Ponderosa Pine bears North 74° East, a distance of 14.88 feet, marked X BT.
- A 11" Ponderosa Pine bears South 26° East, a distance of 8.77 feet, marked C 1/4 S21 BT.
- A 10" Ponderosa Pine bears South 60° West, a distance of 20.44 feet, marked C 1/4 S21 BT.
- A 9" Ponderosa Pine bears North 82° West, a distance of 5.55 feet, marked C 1/4 S21 BT.

Set steel fenceposts 4 feet East and South of corner with US Forest Service Property Boundary signs.


I hereby certify that the corner was monumented on June 29, 2009
Witness: Jeff Hsu, Gregory T. Blackman, Jr.

REGISTERED
PROFESSIONAL
LAND SURVEYOR

Rick G. Robinson

OREGON
July 17, 1986
RICK G. ROBINSON
2219

Renewal Date: December 31, 2010

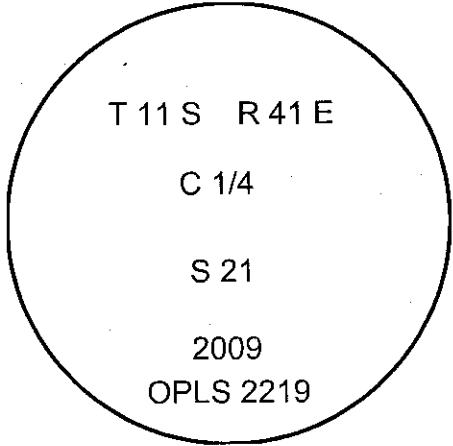

I used a steel tape and magnetic compass in the establishment of the bearing trees. I used 18° East declination. I attached a brass washer marked OPLS 2219 to the BT blaze. The distance is to a 60d spike driven into the root crown at the right side of the new bearing tree.

FILED Sept. 4, 2009
BAKER COUNTY SURVEYOR
SURVEY NO. 11-41-28