

CERTIFIED RECORD OF LAND CORNER MONUMENTATION

HISTORY OF ORIGINAL CORNER ESTABLISHMENT:

Corner not previously established.

DESCRIPTION OF CORNER EVIDENCE FOUND:

None

DESCRIPTION OF MONUMENT AND ACCESSORIES I ESTABLISHED

TO PERPETUATE THE ORIGINAL LOCATION OF THIS CORNER:


At position determined by survey, I set a USDA Forest Service 2 1/2" x 30" Aluminum pipe, with 3" aluminum cap marked as shown, 25" in the ground, from which:

A 15" Ponderosa Pine bears North 59° East, a distance of 39.94 feet, marked CE 1/16 S21 BT.
A 10" Ponderosa Pine bears South 30° East, a distance of 21.12 feet, marked CE 1/16 S21 BT.

Set steel fenceposts 4 feet North and West of corner with US Forest Service Property Boundary signs.

I hereby certify that the corner was monumented on June 29, 2009

Witness: Jeff Hsu, Gregory T. Blackman, Jr.

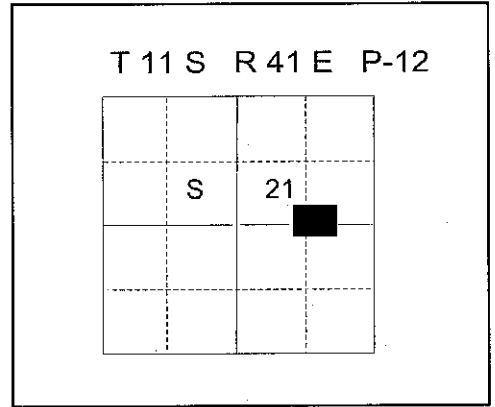


REGISTERED
PROFESSIONAL
LAND SURVEYOR

Rick G. Robinson

OREGON
July 17, 1986

RICK G. ROBINSON
2219

Renewal Date: December 31, 2010

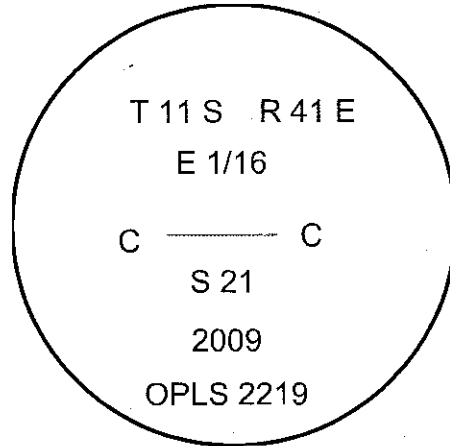

I used a steel tape and magnetic compass in the establishment of the bearing trees. I used 18° East declination. I attached a brass washer marked OPLS 2219 to the BT blaze. The distance is to a 60d spike driven into the root crown at the right side of the bearing trees.

P-12

FILED Sept 4, 2009
BAKER COUNTY SURVEYOR
SURVEY NO. 11-41-29