

CERTIFIED RECORD OF LAND CORNER MONUMENTATION

HISTORY OF ORIGINAL CORNER ESTABLISHMENT:


Originally established by Benjamin Vaughn under GLO Contract No. 211, dated July 14, 1874. Surveyor record states:

Set Stone 12x10x8 for 1/4 Sec. Cor.

Reestablished at proportionate position by C. Albert White under special instructions dated September 3, 1940, included under Group No. 261. Surveyor record states:

Set an iron post, 28 ins. long, 2 1/2 ins. diam., 24 ins. in the ground, from which:

- A fir 24 ins. diam., bears S. 40° E., 65 lks. dist., mkd. 1/4 S22 BT.
- A yellow pine, 20 ins. Diam., bears S. 71° W., 19 lks. dist., mkd. 1/4 S21 BT.

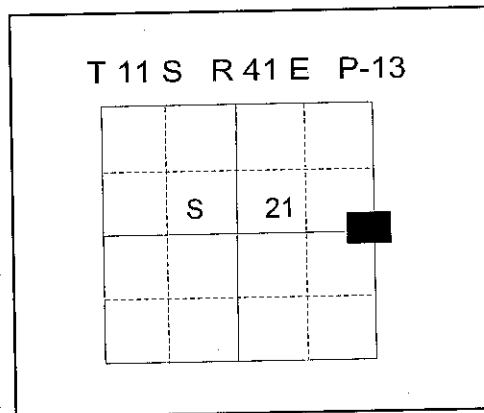

DESCRIPTION OF CORNER EVIDENCE FOUND:

Found Bureau of Land Management 3" Brass cap on 2 1/2" iron post, protruding 9" above ground, from which:

A fir stump bears South 38° East, a distance of 42.57 feet, with visible scribe marks. The remains of a pine stump bears South 73° West, a distance of 12.41 feet.

DESCRIPTION OF MONUMENT AND ACCESSORIES I ESTABLISHED

TO PERPETUATE THE ORIGINAL LOCATION OF THIS CORNER:

NEW BEARING OBJECTS:


- A 7 in. Ponderosa Pine bears North 17° East, a distance of 37.71 feet, marked 1/4 S22 BT.
- A 12 in. Ponderosa Pine bears South 38° East, a distance of 48.57 feet, marked 1/4 S22 BT.
- A 12 in. Ponderosa Pine bears South 18° West, a distance of 21.70 feet, marked 1/4 S21 BT.
- A 9 in. Ponderosa Pine bears North 41° West, a distance of 44.83 feet, marked 1/4 S21 BT.

I hereby certify that the corner was perpetuated on July 2, 2009
 Witness: Jeff Hsu, Gregory T. Blackman, Jr.

REGISTERED
PROFESSIONAL
LAND SURVEYOR

OREGON
July 17, 1986
RICK G. ROBINSON
2219

Renewal Date: December 31, 2010

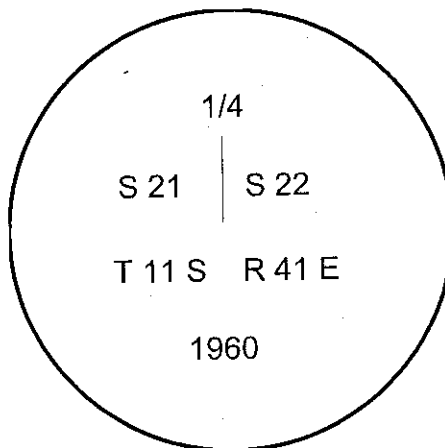

I used a steel tape and magnetic compass in the establishment of the bearing trees. I used 18° East declination. I attached a brass washer marked OPLS 2219 to the BT blaze. The distance is to a 60d spike driven into the root crown at the right side of the new bearing trees.

FILED Sept. 4, 2009
 BAKER COUNTY SURVEYOR
 SURVEY NO. 11-41-30