

CERTIFIED RECORD OF LAND CORNER MONUMENTATION

HISTORY OF ORIGINAL CORNER ESTABLISHMENT:
Corner not established.


DESCRIPTION OF CORNER EVIDENCE FOUND:
None

DESCRIPTION OF MONUMENT AND ACCESSORIES I ESTABLISHED TO PERPETUATE THE ORIGINAL LOCATION OF THIS CORNER:
At position determined by survey, I set a USDA Forest Service 2 1/2" x 30" Aluminum pipe, with 3" aluminum cap marked as shown, 23" in the ground, from which:

A 20" Ponderosa Pine bears South 44° East, a distance of 11.18 feet, marked CS 1/16 S21 BT.
An 18" Ponderosa Pine bears South 85° West, a distance of 16.62 feet, marked CS 1/16 S21 BT.

Set steel fenceposts 4 feet North and West of corner with US Forest Service Property Boundary signs.

I hereby certify that the corner was monumented on July 2, 2009
Witness: Jeff Hsu

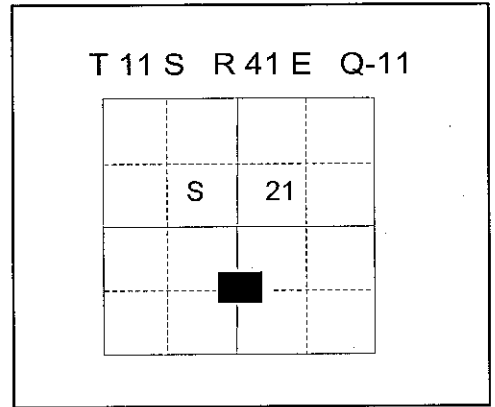


REGISTERED
PROFESSIONAL
LAND SURVEYOR

Rick G. Robinson

OREGON
July 17, 1980
RICK G. ROBINSON
2219

Renewal Date: December 31, 2010

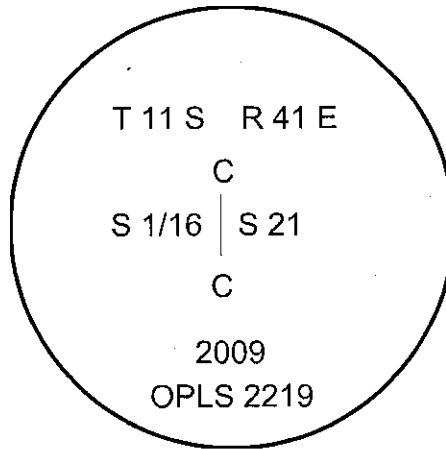

I used a steel tape and magnetic compass in the establishment of the bearing trees. I used 18° East declination. I attached a brass washer marked OPLS 2219 to the BT blaze. The distance is to a 60d spike driven into the root crown at the right side of the bearing trees.

Q-11

FILED Sept. 4, 2009
BAKER COUNTY SURVEYOR
SURVEY NO. 11-41-33