

CERTIFIED RECORD OF LAND CORNER MONUMENTATION

HISTORY OF ORIGINAL CORNER ESTABLISHMENT:

Originally established by Benjamin F. Vaughn under GLO Contract No. 211, dated July 14, 1874. Surveyor record states:

Set stone 14x14x8 for 1/4 sec. cor.

Corner reestablished by C. Albert White under special instructions dated September 3, 1940, included under Group No. 261. Surveyor record states:

Point for the 1/4 sec. cor of secs. 3 and 10, at proportionate distance; there is no remaining evidence of the original corner.

Set an iron post, 28 ins. Long, 2 1/2 ins. diam., 21 ins. in the ground with brass cap. From which:

- A fir, 8 ins. diam., bears N. 28° W., 24 lks. dist., mkd. 1/4 S3 BT.
- A fir, 8 ins. diam., bears S. 73° W, 17 lks. dist., mkd. 1/4 S10 BT.

DESCRIPTION OF CORNER EVIDENCE FOUND:

Found Bureau of Land Management 3" Brass cap on 2 1/2" iron post, 5 inches above ground, from which:

A rotted fir stump bears South 72° West, a distance of 11.20 feet. No scribe marks visible.

DESCRIPTION OF MONUMENT AND ACCESSORIES I ESTABLISHED


TO PERPETUATE THE ORIGINAL LOCATION OF THIS CORNER:

NEW BEARING TREES:

- A 5 inch ponderosa pine, bears North 37° East, a distance of 75.60 feet, marked X BT.
- A 9 inch red fir, bears South 8° East, a distance of 40.90 feet, marked 1/4 S10 BT.
- A 5 inch ponderosa pine, bears South 42° West, a distance of 20.10 feet, marked 1/4 S10 BT.
- An 8 inch ponderosa pine, bears North 19° West, a distance of 46.75 feet, marked 1/4 S3 BT.

Corner falls in a timbered area approximately 50 feet West of a gravel road. Set a steel fence post 1 foot North of monument.

I hereby certify that the corner was perpetuated on April 16, 2012
 Witness: Jeff Hsu

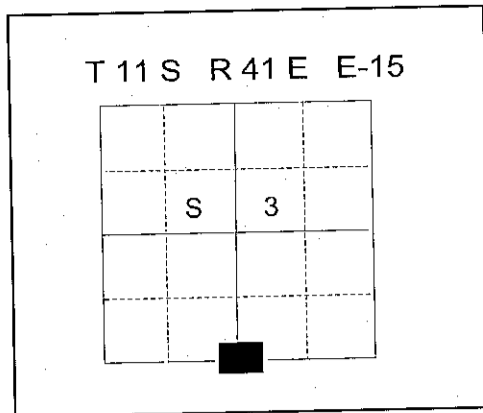


REGISTERED
 PROFESSIONAL
 LAND SURVEYOR

Jeff Hsu

OREGON
 June 2, 2010
 JEFFERY S. HSU
 83571

Renewal Date: June 30, 2013

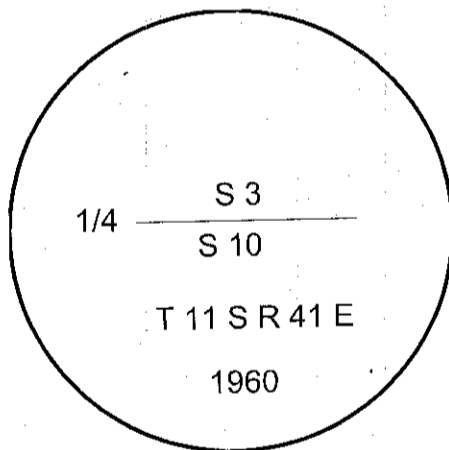

I used a steel tape and magnetic compass in the establishment of the bearing trees. Magnetic declination used was 16° East. Bearings are to a washer in the top of the BT Blaze marked OPLS 83571. Distances are to a 50d spike in the right hand side of the root crown of the tree.

FILED May 3, 2012
 BAKER COUNTY SURVEYOR
 SURVEY NO. 11-41-35