

CERTIFIED RECORD OF LAND CORNER MONUMENTATION

HISTORY OF ORIGINAL CORNER ESTABLISHMENT:

Originally established by Benjamin F. Vaughn under GLO Contract No. 211, dated July 14, 1874. Surveyor record states:

Set Post 4 feet long, 3 in. dia. for 1/4 sec. cor. From which a pine 20 in. dia. bears N. 45° W. 20 lks. dist.

Corner reestablished by C. Albert White under special instructions dated September 3, 1940, included under Group No. 261. Surveyor record states:

Point for 1/4 sec. cor. of secs. 10 and 15, at proportionate distance; there is no remaining evidence of the original corner.

Set an iron post, 28 ins. Long, 2 1/2 ins. diam., 24 ins. in the ground, with brass cap. From which:

A yellow pine, 8 ins. diam., bears N. 70 1/2° E., 14 lks. dist., mkd 1/4 S10 BT.
A yellow pine, 8 ins. diam., bears S. 32 1/2° W., 20 1/2 lks. dist., mkd. 1/4 S15 BT.

DESCRIPTION OF CORNER EVIDENCE FOUND:

Found Bureau of Land Management 3" Brass cap, marked as shown below, on 2 1/2" iron post, 4 inches above ground, from which:

A 17 inch Ponderosa Pine bears North 71° East, a distance of 9.50 feet, alive and vigorous with healed blaze.
A 16 inch Ponderosa Pine bears South 33° West, a distance of 13.90 feet, alive and vigorous with healed blaze.


DESCRIPTION OF MONUMENT AND ACCESSORIES I ESTABLISHED

TO PERPETUATE THE ORIGINAL LOCATION OF THIS CORNER:

NEW BEARING TREES:


A 13 inch Ponderosa Pine bears South 62° East, a distance of 42.70 feet, marked 1/4 S15 BT.
A 16 inch Ponderosa Pine bears North 67° West, a distance of 43.30 feet, marked 1/4 S10 BT.

I hereby certify that the corner was perpetuated on April 18, 2012
Witness: Jeff Hsu

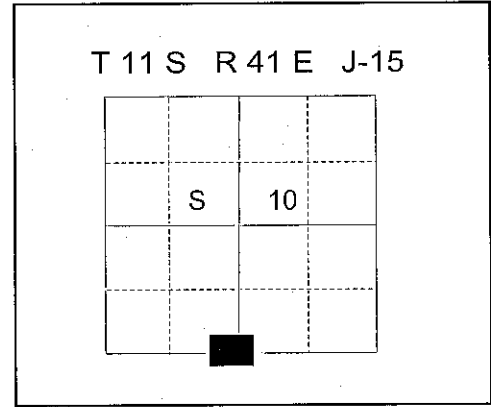

REGISTERED
PROFESSIONAL
LAND SURVEYOR
Jeff Hsu
OREGON
June 2, 2010
JEFFERY S. HSU
83571

Renewal Date: June 30, 2013

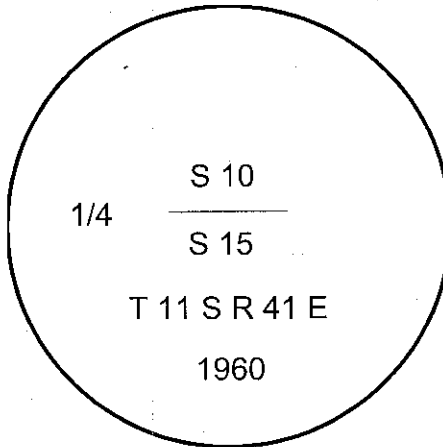

I used a steel tape and magnetic compass in the establishment of the bearing trees. Magnetic declination used was 16° East. Bearings for the new bearing trees are to a washer in the top of the BT Blaze marked OPLS 83571. Bearing for the old bearing trees are to the center of the tree at the root crown. Distances are to a 50d spike in the right hand side of the root crown of the tree.

FILED May 3, 2012
BAKER COUNTY SURVEYOR
SURVEY NO. 11-41-36