

**CERTIFIED RECORD OF LAND CORNER MONUMENTATION**

**HISTORY OF ORIGINAL CORNER ESTABLISHMENT:**

Originally established by Benjamin F. Vaughn under GLO Contract No. 211, dated July 14, 1874. Surveyor record states:


Set stone 12x10x8 for cor. to secs. 2, 3, 10 and 11.

Corner reestablished by C. Albert White under special instructions dated September 3, 1940, included under Group No. 261. Surveyor record states:

Point for the cor. of secs. 2, 3 10 and 11, at proportionate distance; there is no remaining evidence of the original corner.

Set an iron post, 28 ins. Long, 2 ½ ins. diam., 22 ins. in the ground with brass cap. From which:

- A yellow pine, 6 ins. diam., bears N. 10° E., 45 lks. dist., mkd. T11S R41E S2 BT.
- A yellow pine, 6 ins. diam., bears S. 62 ½° E., 42 lks. dist., mkd. T11S R41E S11 BT.
- A yellow pine, 6 ins. diam., bears S. 14° W., 73 lks. dist., mkd. T11S R41E S10 BT.
- A yellow pine, 9 ins. diam., bears N. 86 ½° W., 45 lks. dist., mkd. T11S R41E S3 BT.

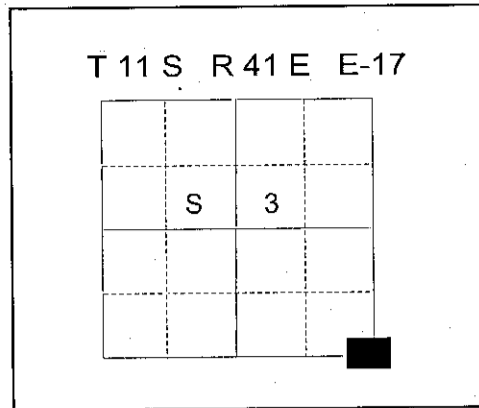

**DESCRIPTION OF CORNER EVIDENCE FOUND:**

Found Bureau of Land Management 3" Brass cap, marked as shown below, on 2 ½" iron post, 10 inches above ground, from which:

- A 10 inch ponderosa pine bears North 10° East, a distance of 29.70 feet, alive and vigorous with healed blaze.
  - A 16 inch ponderosa pine bears South 62 ½° East, a distance of 27.40 feet, alive and vigorous with healed blaze.
  - A 15 inch ponderosa pine bears South 14° West, a distance of 47.90 feet, alive and vigorous with healed blaze.
- There are no remains of the Northwest bearing tree.

**DESCRIPTION OF MONUMENT AND ACCESSORIES I ESTABLISHED**

**TO PERPETUATE THE ORIGINAL LOCATION OF THIS CORNER:**

**NEW BEARING TREES:**

- A 16 inch ponderosa pine bears North 29° West, a distance of 25.55 feet, marked T11S R41E S3 BT.


I hereby certify that the corner was perpetuated on April 18, 2012  
Witness: Jeff Hsu

REGISTERED  
PROFESSIONAL  
LAND SURVEYOR

OREGON  
June 2, 2010

**JEFFERY S. HSU**  
83571

Renewal Date: June 30, 2013

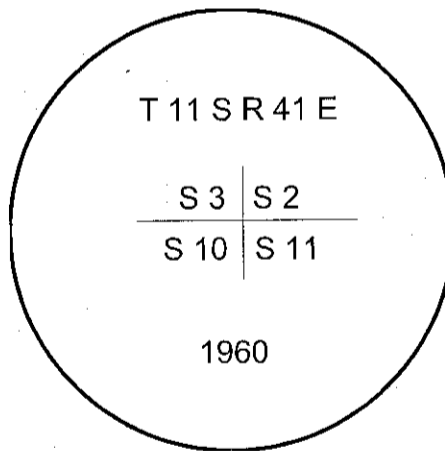

I used a steel tape and magnetic compass in the establishment of the bearing trees. Magnetic declination used was 16° East. Bearings to the new bearing tree are to a washer in the top of the BT Blaze marked OPLS 83571. Bearings to old bearing trees are to the center of the tree at the root crown. Distances are to a 50d spike in the right hand side of the root crown of the tree.

FILED May 3, 2012  
BAKER COUNTY SURVEYOR  
SURVEY NO. 11-41-37