


CERTIFIED RECORD OF LAND CORNER MONUMENTATION

HISTORY OF ORIGINAL CORNER ESTABLISHMENT:
Corner not previously established.

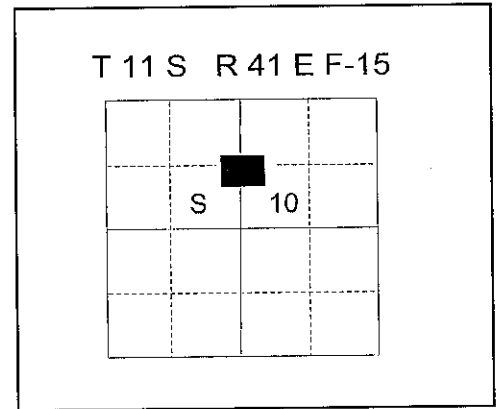

DESCRIPTION OF CORNER EVIDENCE FOUND:
None.

See Survey for Gallatin NE Oregon Land and Timber, dated May 2012.

DESCRIPTION OF MONUMENT AND ACCESSORIES I ESTABLISHED
TO PERPETUATE THE ORIGINAL LOCATION OF THIS CORNER:

At position determined by survey, I set a 5/8" x 30" iron pin with 2 inch aluminum cap, marked as shown below, 26 inches in the ground, from which:

- A 7 inch Douglas Fir bears South 46° East, a distance of 17.65 feet, marked CN 1/16 S10 BT.
- A 7 inch Ponderosa Pine bears South 79° West, a distance of 30.80 feet, marked CN 1/16 S10 BT.


Set steel fence post 1 foot North of monument.

I hereby certify that the corner was monumented on May 1, 2012
Witness: Rick G. Robinson

REGISTERED
PROFESSIONAL
LAND SURVEYOR

Jeffery S. Hsu
OREGON
June 2, 2010
JEFFERY S. HSU
83571

Renewal Date: June 30, 2013

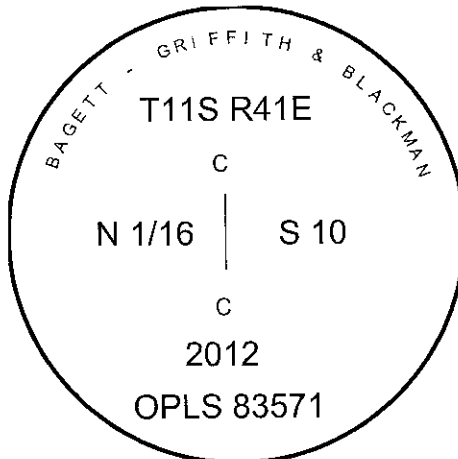

I used a steel tape and magnetic compass in the establishment of the bearing trees. Magnetic declination used was 16° East. Bearings are to a washer in the top of the BT Blaze marked OPLS 83571. Distances are to a 50d spike in the right hand side of the root crown of the tree.

FILED May 3, 2012
BAKER COUNTY SURVEYOR
SURVEY NO. 11-41-38