

**CERTIFIED RECORD OF LAND CORNER MONUMENTATION**

**HISTORY OF ORIGINAL CORNER ESTABLISHMENT:**


Originally established by C. Albert White under special instructions dated September 3, 1940, included under Group No. 261. Surveyor record states:

Point for N 1/16 sec. cor. of secs. 10 and 11.

Set an iron post, 28 ins. Long, 2 1/2 ins. diam., 22 ins. in the ground, with brass cap. From which:

A fir, 7 ins. diam., bears N. 69° E., 24 lks. dist., mkd 1/16 S11 BT.

A fir, 7 ins. diam., bears S. 72 1/2° W., 23 lks. dist., mkd. 1/16 S10 BT.

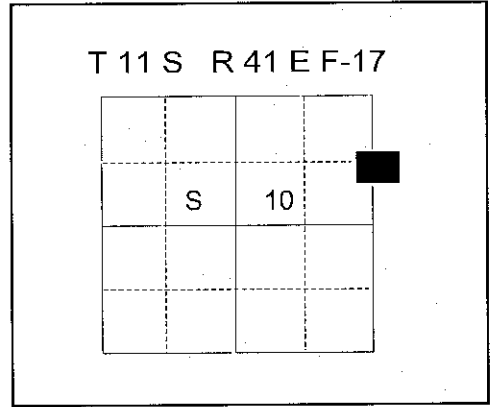

**DESCRIPTION OF CORNER EVIDENCE FOUND:**

Found Bureau of Land Management 3" Brass cap, marked as shown below, on 2 1/2" iron post, 8 inches above ground, from which:

A 15 inch Douglas Fir bears North 69° East, a distance of 15.80 feet, alive and vigorous with a healed blaze.

There are no remains of the Southwest bearing tree.

**DESCRIPTION OF MONUMENT AND ACCESSORIES I ESTABLISHED**

**TO PERPETUATE THE ORIGINAL LOCATION OF THIS CORNER:**

**NEW BEARING TREE:**

An 11 inch Douglas Fir bears South 36° West, a distance of 15.15 feet, marked N 1/16 S10 BT.

Set a steel fence post 1 foot West of monument.

I hereby certify that the corner was perpetuated on April 18, 2012


Witness: Jeff Hsu

REGISTERED  
PROFESSIONAL  
LAND SURVEYOR



OREGON  
June 2, 2010  
JEFFERY S. HSU  
83571

Renewal Date: June 30, 2013

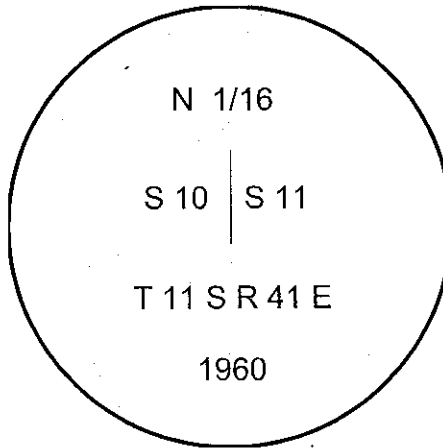

I used a steel tape and magnetic compass in the establishment of the bearing trees. Magnetic declination used was 16° East. Bearings to the new bearing tree are to a washer in the top of the BT Blaze marked OPLS 83571. Bearing to the old bearing tree are to the center of the tree at the root crown. Distances are to a 50d spike in the right hand side of the root crown of the tree.

FILED May 3, 2012  
BAKER COUNTY SURVEYOR  
SURVEY NO. 11-41-39