

CERTIFIED RECORD OF LAND CORNER MONUMENTATION

HISTORY OF ORIGINAL CORNER ESTABLISHMENT:


Originally established by Benjamin F. Vaughn under GLO Contract No. 211, dated July 14, 1874. Surveyor record states:

Set stone 14x10x10 for closing cor. to secs. 2 and 3.

Corner found and reestablished by C. Albert White under special instructions dated September 3, 1940, included under Group No. 261. Surveyor record states:

Point for the closing cor. of secs. 2 and 3, on the N. Bdy. of T. 11 S., R. 41 E., at proportionate distance; there is no remaining evidence of the original corner.

Set an iron post, 28 ins. Long, 2 1/2 ins. diam., 24 ins. in the ground with brass cap. A mound of stone, 2 ft. diam., 4 th. High, used as a fence cradle, bears South, 2 lks. dist.

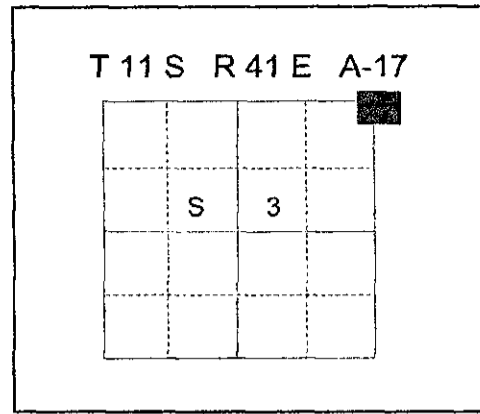

DESCRIPTION OF CORNER EVIDENCE FOUND:

Found Bureau of Land Management 3" Brass cap on 2 1/2" iron post, protruding 11" above ground, in the Northeast corner of a rock jack. The standard corner to Sections 34 and 35, T10S, R41E, bears South 89° East, 17.02 feet.

A 16 inch juniper bears North 37° West, a distance of 104.10 feet, alive and vigorous with scribe marks visible on a partially healed blaze. Bearing tree was originally taken by BLM surveyor C. Albert White to reference the aforementioned standard corner.

DESCRIPTION OF MONUMENT AND ACCESSORIES I ESTABLISHED TO PERPETUATE THE ORIGINAL LOCATION OF THIS CORNER: NEW BEARING OBJECTS:

A 6 inch wooden fence post bears North 52° East, a distance of 25.00 feet, with brass washer marked OPLS 83571 nailed in top.

A 3 inch juniper bears South 22° East, a distance of 54.40 feet, marked X BT.

A 4 inch juniper bears South 46° West, a distance of 28.03 feet, marked X BT.


Corner falls West of in the Northeast corner of a rock jack on the West side of a dirt road. An old fenceline, mostly downed, runs West out of the rock jack.

I hereby certify that the corner was perpetuated on April 16, 2012
Witness: Jeff Hsu

REGISTERED
PROFESSIONAL
LAND SURVEYOR

Jeff Hsu
OREGON
June 2, 2010
JEFFERY S. HSU
83571

Renewal Date: June 30, 2013

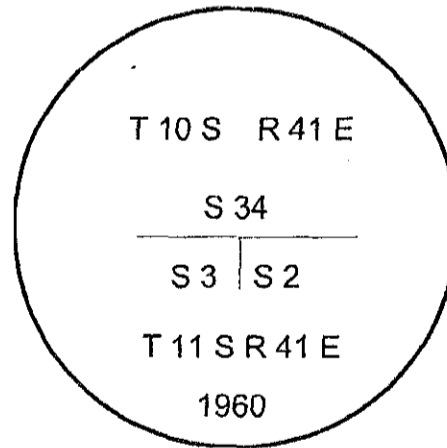

I used a steel tape and magnetic compass in the establishment of the bearing trees. I used 16° East declination. I attached a brass washer marked OPLS 83571 to the BT blaze. The distance is to a 60d spike driven into the root crown at the left side of the new bearing trees and to the center of the brass washer on the fence corner.

A-17

FILED May 3, 2012
BAKER COUNTY SURVEYOR
SURVEY NO. 10-41-13
11-41-47