

CERTIFIED RECORD OF LAND CORNER MONUMENTATION


HISTORY OF ORIGINAL CORNER ESTABLISHMENT:

Originally established by Benjamin F. Vaughn under GLO Contract No. 211, dated July 14, 1874. Surveyor record states:

Set stone 12x10x10 for cor. for 1/4 sec. cor.

DESCRIPTION OF CORNER EVIDENCE FOUND:

None found.

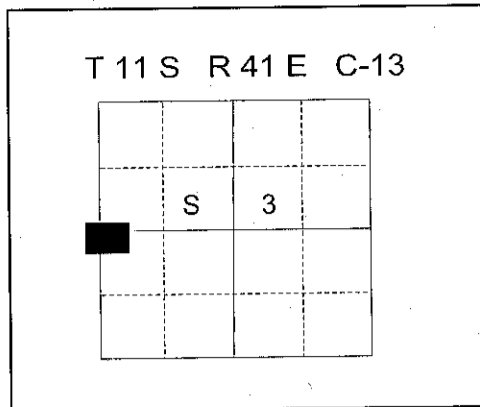

DESCRIPTION OF MONUMENT AND ACCESSORIES I ESTABLISHED

TO PERPETUATE THE ORIGINAL LOCATION OF THIS CORNER:

At proportionate position, I set a 1 1/2" iron pipe with 2 1/2" brass cap, marked as shown below, 26 inches in the ground, in a collar of stone 2 ft. wide, from which:

- A 9 inch Ponderosa Pine bears North 29° East, a distance of 37.10 feet, marked 1/4 S3 BT.
- A 16 inch Ponderosa Pine bears South 26° East, a distance of 21.75 feet, marked 1/4 S3 BT.
- An 11 inch Ponderosa Pine bears North 75° West, a distance of 14.55 feet, marked 1/4 S4 BT.
- A 13 inch Ponderosa Pine bears North 10° West, a distance of 35.00 feet, marked 1/4 S4 BT.

NOTE: There are two bearing trees in the Northwest quadrant.

Corner falls in a ponderosa pine stand, approximately 80 feet West of a North/South running fence.

I hereby certify that the corner was monumented on April 25, 2012

Witness: Jeff Hsu

REGISTERED
PROFESSIONAL
LAND SURVEYOR



OREGON
June 2, 2010
JEFFERY S. HSU
83571

Renewal Date: June 30, 2013

BAGETT - GRIFFITH & BLACKMAN

T11S R41E

1/4

S 4 | S 3

2012

PLS 83571

I used a steel tape and magnetic compass in the establishment of the bearing trees. Magnetic declination used was 16° East. Bearings are to a washer in the top of the BT Blaze marked OPLS 83571. Distances are to a 50d spike in the right hand side of the root crown of the tree.

FILED May 3, 2012
BAKER COUNTY SURVEYOR
SURVEY NO. 11-41-48