


**CERTIFIED RECORD OF LAND CORNER MONUMENTATION**

HISTORY OF ORIGINAL CORNER ESTABLISHMENT:  
Corner not previously established.

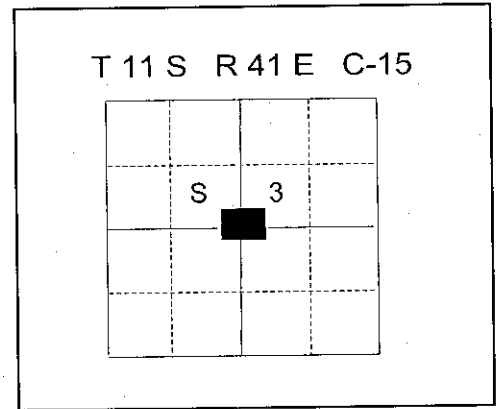

DESCRIPTION OF CORNER EVIDENCE FOUND:  
None

DESCRIPTION OF MONUMENT AND ACCESSORIES I ESTABLISHED  
TO PERPETUATE THE ORIGINAL LOCATION OF THIS CORNER:

At position determined by survey, I set a 1 1/2"x30" iron pipe with a 2 1/2" brass cap marked as shown below, 26" in the ground, from which:

- A 7 inch Douglas Fir bears North 44° East, a distance of 30.60 feet, marked C1/4 S3 BT.
- An 8 inch Ponderosa Pine bears South 10° East, a distance of 20.75 feet, marked C 1/4 S3 BT.
- A 10 inch Ponderosa Pine bears South 51° West, a distance of 14.45 feet, marked C1/4 S3 BT.
- A 6 inch Ponderosa Pine bears North 87° West, a distance of 29.50 feet, marked C1/4 S3 BT.

Corner falls on a North facing slope, approximately 7 feet North of an East/West running fenceline, and about 80 feet West of a North/South running fenceline.

Set a steel fence post 1 foot South of monument.


I hereby certify that the corner was monumented on April 24, 2012  
Witness: Jeff Hsu

REGISTERED  
PROFESSIONAL  
LAND SURVEYOR



OREGON  
June 2, 2010  
JEFFERY S. HSU  
83571

Renewal Date: June 30, 2013

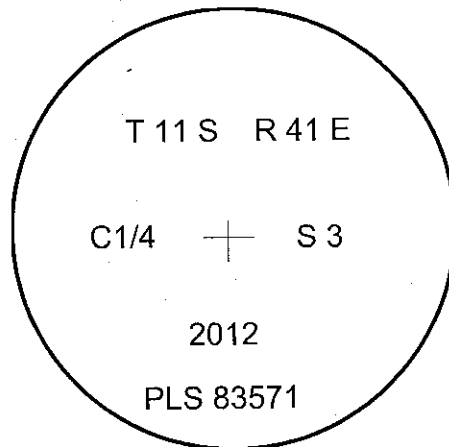

Bearings to the accessories are established by magnetic compass and distances by steel tape. Magnetic declination used was 16° East. Distance is to a 50d spike placed in the right hand side of the root crown with exception of the Southwest bearing tree, which has the spike placed in the left hand side.

FILED May 3, 2012  
BAKER COUNTY SURVEYOR  
SURVEY NO. 11-41-469