

CERTIFIED RECORD OF LAND CORNER MONUMENTATION

HISTORY OF ORIGINAL CORNER ESTABLISHMENT:

Originally established by Benjamin F. Vaughn under GLO Contract No. 211, dated July 14, 1874. Surveyor record states:

Set stone 12x10x8 for cor. to Secs 3, 4, 9 and 10, from which:


A pine 30 in. dia. bears N. 85° West, 15 lks. dist.

Corner reestablished by C. Albert White under special instructions dated September 3, 1940, included under Group No. 261. Surveyor record states:

Point for the cor. of secs. 3, 4, 9, and 10, at proportionate distance; there is no remaining evidence of the original corner.

Set an iron post, 28 ins. Long, 2 1/2 ins. diam., 21 ins. in the ground and in a mound of stone, 3 ft. base, to top, with brass cap. From which:

- A fir, 8 ins. diam., bears N. 63° E., 41 lks. dist., mkd. T11S R41E S3 BT.
- A yellow pine, 14 ins. diam., bears s. 35° E, 91 lks. dist., mkd. T11S R41E S10 BT.
- A yellow pine, 20 ins. diam., bears S. 83° W., 69 lks. dist., mkd. T11S R41E S9 BT.
- A fir, 8 ins. diam., bears N. 59° W., 7 lks. dist., mkd. T11S R41E S4 BT.

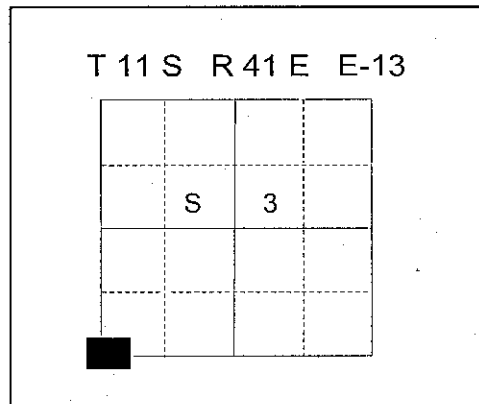

DESCRIPTION OF CORNER EVIDENCE FOUND:

Found Bureau of Land Management 3" Brass cap on 2 1/2" iron post, protruding 5 ins. above ground, in mound of stone 2 ft. diam., from which:

A 15 inch red fir bears North 63° East, a distance of 27.00 feet, alive and vigorous with fully healed blaze.

A 19 inch ponderosa pine bears South 32° East, a distance of 60.10 feet, alive and vigorous with fully healed blaze.

An 18 inch ponderosa pine, bears South 83° West, a distance of 45.50 feet, alive and vigorous with fully healed blaze.

A 13 inch red fir, bears North 72° West, a distance of 4.90 feet, alive and vigorous with fully healed blaze.


DESCRIPTION OF MONUMENT AND ACCESSORIES I ESTABLISHED TO PERPETUATE THE ORIGINAL LOCATION OF THIS CORNER:

Corner falls on a timbered East facing slope.

I hereby certify that the corner was perpetuated on April 16, 2012
Witness: Jeff Hsu



Renewal Date: June 30, 2013

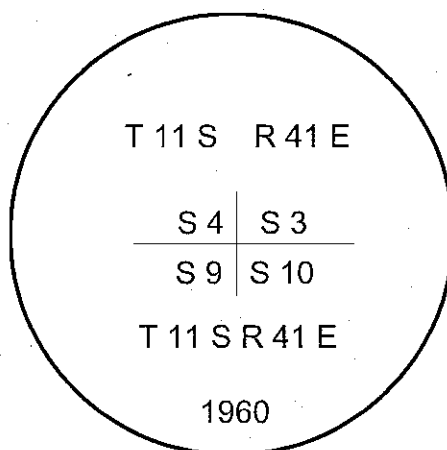

I used a steel tape and magnetic compass in the establishment of the accessories. Magnetic declination used was 16° East. Bearings and distances are to the center of the tree at the root crown.

FILED *May 3, 2012*
BAKER COUNTY SURVEYOR
SURVEY NO. *11-41-51*