

CERTIFIED RECORD OF LAND CORNER MONUMENTATION

HISTORY OF ORIGINAL CORNER ESTABLISHED:

Corner originally established by Benjamin F. Vaughn under GLO Contract No. 211, dated July 1874.
Survey General States:

Set post 4 in. square 4 feet long for 1/4 Sec cor.
From which:
A Pine 20 ins. bears S 50° E, 40 lks.


Corner revisited by Henry W. Cooke under his Contract No. 418, dated August 30, 1882. He found a post 3 ft. long, 3 ins. square, 24 ins. in the ground marked 1/4 on W. face from which:
A Pine 20 ins in dia. bears S 50° E 40 lks. dist.
marked 1/4 S BT

Corner reset at proportionate position by C. Albert White in dependent resurvey, completed under special instructions dated September 3, 1940, Group No. 261. Which states:

Set and iron post, 28 ins. long, 2 1/2 ins. diam., 24 ins. in the ground with brass cap marked as shown below. From which:

A Yellow Pine, 10 ins. diam., bears S 62° E, 61 lks. dist., mkd. 1/4 S18 BT.
A Fir, 15 ins. diam., bears S 12° E, 71 lks. dist., mkd. 1/4 S18 BT.

T 11 S R 41 E L-01

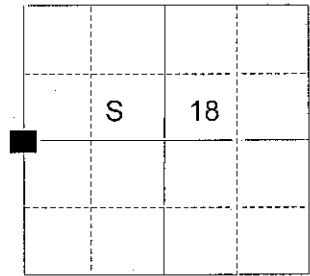

DESCRIPTION OF CORNER EVIDENCE FOUND:

Found a 2 1/2" iron pipe with a 3" brass cap, 3" above ground, from which:

A 21" Ponderosa Pine bears S 62° E, a distance of 40.26 ft, alive and vigorous with a healed blaze.
A stump hole bears S 12° E, a distance of 47.00 ft.

DESCRIPTION OF MONUMENT AND ACCESSORIES I ESTABLISHED

TO PERPETUATE THE ORIGINAL LOCATION OF THIS CORNER:

From the iron pipe monument

NEW BEARING OBJECTS:


A 7" Ponderosa Pine bears N 87° E, a distance of 44.35', marked 1/4 S18 BT.

I hereby certify that the corner was perpetuated on July 14, 2014.

Witness: Thomas J. Kopp



Renewal Date: June 30, 2015

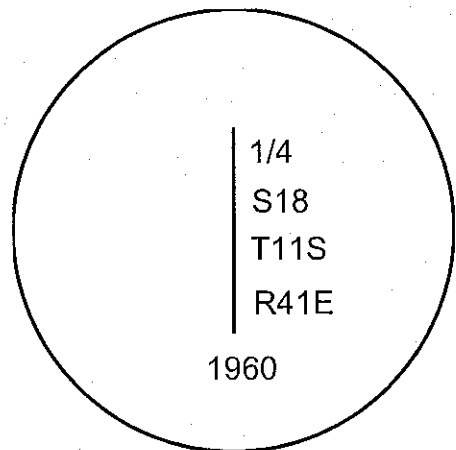

I used a steel tape and magnetic compass in the establishment of the new accessory. I used 16° East declination, the distances are to a 60d spike driven into the right side of the root crown of the new bearing tree. A brass washer marked OPLS 83571 is attached to the BT blaze of the new bearing tree.

L-01

FILED Aug. 5, 2014
BAKER COUNTY SURVEYOR
SURVEY NO. 11-41-55