

**CERTIFIED RECORD OF LAND CORNER MONUMENTATION**

**HISTORY OF ORIGINAL CORNER ESTABLISHED:**

Corner originally established by Benjamin F. Vaughn under GLO Contract No. 211, dated July 1874.  
Survey General States:


Set stone 14x10x8 for 1/4 Sec. corner.

Corner reset at proportionate position by C. Albert White in dependent resurvey, completed under special instructions dated September 3, 1940, Group No. 261. Which states:

Set and iron post, 28 ins. long, 2 1/2 ins. diam., 24 ins. in the ground with brass cap marked as shown below. From which:

- A Yellow Pine, 7 ins. diam., bears S 82 1/2° E, 38 lks. dist., mkd. 1/4 S17 BT.
- A Yellow Pine, 6 ins. diam., bears N 67° W, 16 1/2 lks. dist., mkd. 1/4 S18 BT.

T 11 S R 41 E L-05

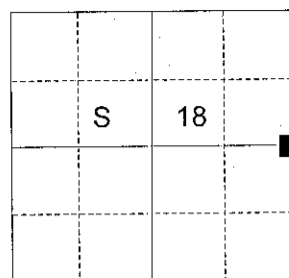

**DESCRIPTION OF CORNER EVIDENCE FOUND:**

Found a 2 1/2" iron pipe with a 3" brass cap, 3" above ground, from which:

- A 17" pine stump bears S 82° E, a distance of 25'.
- A 19" Ponderosa Pine bears N 65° W, a distance of 10.50', alive and vigorous with a healed blaze.

**DESCRIPTION OF MONUMENT AND ACCESSORIES I ESTABLISHED**

**TO PERPETUATE THE ORIGINAL LOCATION OF THIS CORNER:**

From the iron pipe monument,


**NEW BEARING OBJECTS:**

- A 15" Douglas Fir bears N 74° E, a distance of 31.90 ft., marked 1/4 S17 BT.
- A 13" Ponderosa Pine bears S 6° E, a distance of 37.70 ft., marked 1/4 S17 BT.
- A 13" Ponderosa Pine bears S 40° W, a distance of 70.00 ft., marked 1/4 S18 BT.

I hereby certify that the corner was perpetuated on July 14, 2014.


Witness: Thomas J. Kopp

REGISTERED  
PROFESSIONAL  
LAND SURVEYOR

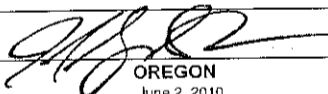

OREGON  
June 2, 2010  
JEFFREY S. HSU  
83571

Renewal Date: June 30, 2015

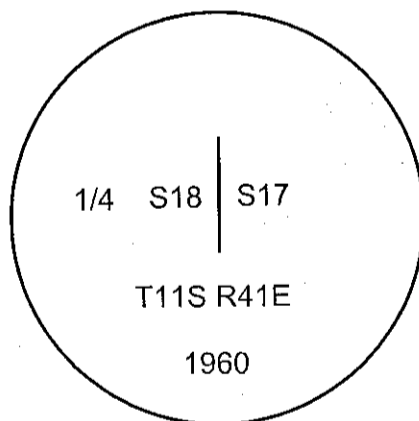

I used a steel tape and magnetic compass in the establishment of the new accessories. I used 16° East declination, the distances are to a 60d spike driven into the right side of the root crown of the new bearing trees. A brass washer marked OPLS 83571 is attached to the BT blaze of the new bearing trees.

FILED Aug. 5, 2014  
BAKER COUNTY SURVEYOR  
SURVEY NO. 11-41-56