


CERTIFIED RECORD OF LAND CORNER MONUMENTATION

HISTORY OF ORIGINAL CORNER ESTABLISHED:

Corner not previously established. There is evidence that the Bureau of Land Management has used an approximate position, as evidenced by a tag on a high stumped pine marked "FOR BLM USE ONLY, Corner is 25', N74W"

T 11 S R 41 E M-03

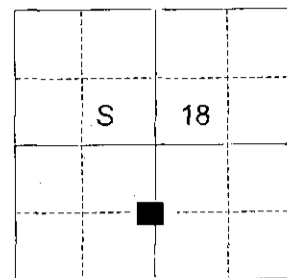

DESCRIPTION OF CORNER EVIDENCE FOUND:

None. From position as determined by survey, a high stumped pine with BLM tag (as previously mentioned), bears North 71° East, a distance of 23.0 feet.

DESCRIPTION OF MONUMENT AND ACCESSORIES I ESTABLISHED

TO PERPETUATE THE ORIGINAL LOCATION OF THIS CORNER:

At position as determined by survey, I set a 5/8" x 30" iron pin, 26 inches in the ground, with 2 1/2" aluminum cap, marked as shown below, in a collar of stone, 1 ft. diam., from which:


- A 17 inch Ponderosa Pine bears South 25° West, a distance of 38.15 feet, marked CS 1/16 S18 BT.
- A 12 inch Ponderosa Pine bears North 75° West, a distance of 70.40 feet, marked CS 1/16 S18 BT.

I hereby certify that the corner was monumented on July 16, 2014.

Witness: Thomas J. Kopp

REGISTERED
PROFESSIONAL
LAND SURVEYOR
[Signature]
OREGON
June 2, 2010
JEFFREY S. HSU
83571

Renewal Date: June 30, 2015

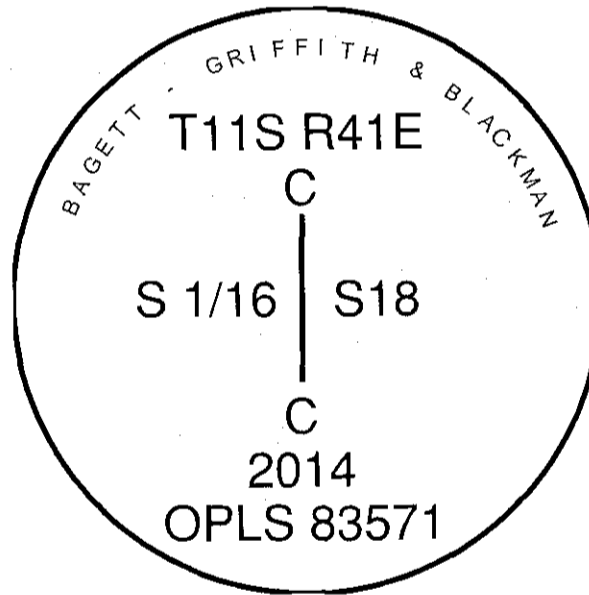

I used a steel tape and magnetic compass in the establishment of the new accessories. I used 16° East declination, the distances are to a 60d spike driven into the right side of the root crown of the new bearing trees. A brass washer marked OPLS 83571 is attached to the BT blaze of the new bearing tree.

M-03

FILED Aug. 5, 2014
BAKER COUNTY SURVEYOR
SURVEY NO. 11-41-57