

CERTIFIED RECORD OF LAND CORNER MONUMENTATION

HISTORY OF ORIGINAL CORNER ESTABLISHED:

Corner originally established by Benjamin F. Vaughn under GLO Contract No. 211, dated July 1874.
Survey General States:


Set stone 12x10x10 for 1/4 Sec. corner.

Corner reset at proportionate position by C. Albert White in dependent resurvey, completed under special instructions dated September 3, 1940, Group No. 261. Which states:

Set and iron post, 28 ins. long, 2 1/2 ins. diam., 24 ins. in the ground with brass cap marked as shown below. From which:

A Yellow Pine, 18 ins. diam., bears N 42° E, 65 lks. dist., mkd. 1/4 S18 BT.
A Fir, 9 ins. diam., bears S 1° W, 302 lks. dist., mkd. 1/4 S19 BT.


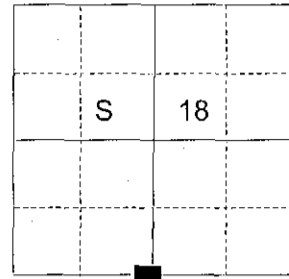

DESCRIPTION OF CORNER EVIDENCE FOUND:

Found a 2 1/2" iron pipe with a 3" brass cap, 6" above ground, from which:

A stump hole bears N 42° E, a distance of 43.0 ft, with a 25" tree dead and down with a healed blaze.
A 14" fir stump bears S 1° W, a distance of 199.0'.

DESCRIPTION OF MONUMENT AND ACCESSORIES I ESTABLISHED TO PERPETUATE THE ORIGINAL LOCATION OF THIS CORNER:

From the iron pipe monument,

NEW BEARING OBJECTS:

A 14" Ponderosa Pine bears N 7° E, a distance of 105.95', marked 1/4 S18 BT.
A 4" Ponderosa Pine bears S 58° E, a distance of 11.30', marked X BT.
A 13" Ponderosa Pine bears West, a distance of 57.40', marked 1/4 S18 BT.
A 5" Ponderosa Pine bears S 36° W, a distance of 41.25', marked 1/4 S19 BT.


Set a steel fencepost approximately 1 foot North of corner monument.

I hereby certify that the corner was perpetuated on July 14, 2014.

Witness: Thomas J. Kopp



Renewal Date: June 30, 2015

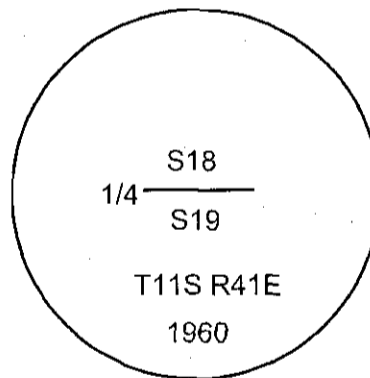

I used a steel tape and magnetic compass in the establishment of the new accessories. I used 16° East declination, the distances are to a 60d spike driven into the right side of the root crown of the new bearing trees. A brass washer marked OPLS 83571 is attached to the BT blaze of the new bearing trees.

N-03

FILED Aug. 5, 2014
BAKER COUNTY SURVEYOR
SURVEY NO. 11-41-50