

CERTIFIED RECORD OF LAND CORNER MONUMENTATION

HISTORY OF ORIGINAL CORNER ESTABLISHED:

Corner originally established by Benjamin F. Vaughn under GLO Contract No. 211, dated July 1874. Survey General record states:

Set stone 14x12x10 for 1/4 Sec. corner.


Corner reset at proportionate position by C. Albert White in dependent resurvey, completed under special instructions dated September 3, 1940, Group No. 261. Field notes state:

Set and iron post, 28 ins. long, 2 1/2 ins. diam., 22 ins. in the ground with brass cap. From which:

A fir, 12, ins. diam., bears N. 84° E., 59 lks. dist., mkd. 1/4 S2 BT.

A yellow pine, 14 ins. diam., bears S. 17° E., 54 lks. dist., mkd. 1/4 S11 BT.

T 11 S R 41 E E-19

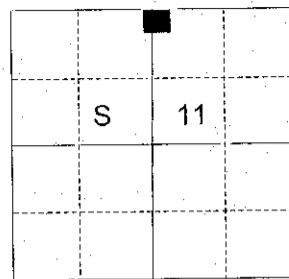

DESCRIPTION OF CORNER EVIDENCE FOUND:

Found a 2 1/2" x 30" iron pipe with a 3" brass cap, lying horizontal on the ground disturbed. Found a 14" stump with BT scribing visible, bears N 84° E, a distance of 38.94'.

DESCRIPTION OF MONUMENT AND ACCESSORIES I ESTABLISHED TO PERPETUATE THE ORIGINAL LOCATION OF THIS CORNER:

At record bearing and distance from stump, I reset the 2 1/2" x 30" iron pipe with a 3" brass cap, 18" in the ground, marked as shown. From which:

NEW BEARING OBJECTS:

- A 11" Ponderosa Pine bears N 71° E, 51.20', marked 1/4 S2 BT.
- A 4" Ponderosa Pine bears S 28° E, 22.00', marked 1/4 S11 BT.
- A 6" Ponderosa Pine bears S 28° W, 34.50', marked 1/4 S11 BT.
- A 14" Ponderosa Pine bears N 39° W, 22.55', marked 1/4 S2 BT.


I hereby certify that the corner was perpetuated on August 4, 2014.

Witness: Thomas J. Kopp

REGISTERED
PROFESSIONAL
LAND SURVEYOR

Jeffrey S. Hsu
OREGON
June 2, 2010
JEFFREY S. HSU
83571

Renewal Date: June 30, 2015

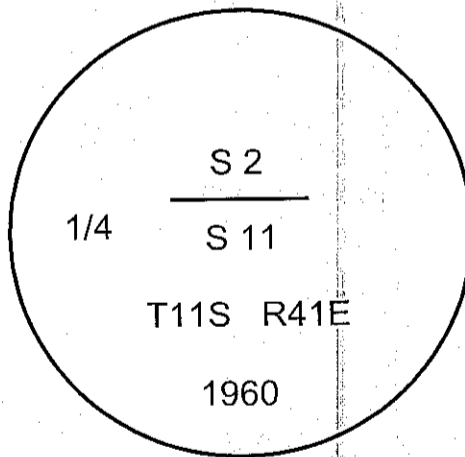

I use a steel tape and magnetic compass in the establishment of the new bearing trees. I use 16° East declination. Distances are to a 60d spike in the right hand side of the root crown. Bearings are to a brass washer marked OPLS 83571 in the lower BT blaze.

FILED Aug. 11, 2014
BAKER COUNTY SURVEYOR
SURVEY NO. 11-41-61