

**CERTIFIED RECORD OF LAND CORNER MONUMENTATION**

**HISTORY OF ORIGINAL CORNER ESTABLISHED:**

Corner originally established by Benjamin F. Vaughn under GLO Contract No. 211, dated July 1874. Survey General record states:

Set stone 12x10x8 for 1/4 Sec. corner.


Corner reset at proportionate position by C. Albert White in dependent resurvey, completed under special instructions dated September 3, 1940, Group No. 261. Field notes state:

Set and iron post, 28 ins. long, 2 1/2 ins. diam., 22 ins. in the ground with brass cap. From which:

A yellow pine, 6 ins. diam., bears S 48 1/2° E., 7 lks. dist., mkd. 1/4 S12 BT.

A fir, 8 ins. diam., bears N 71 1/2° W., 22 lks. dist., mkd. 1/4 S11 BT.

T 11 S R 41 E G-21

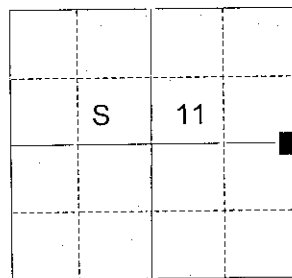

**DESCRIPTION OF CORNER EVIDENCE FOUND:**

Found a 2 1/2" iron pipe with a 3" brass cap, marked as shown below, 6" above ground, from which:

An 18 inch fir stump bears N 71° W, a distance of 14.3 feet, with healed blaze evident. No remaining evidence of SE bearing tree.

**DESCRIPTION OF MONUMENT AND ACCESSORIES I ESTABLISHED**

**TO PERPETUATE THE ORIGINAL LOCATION OF THIS CORNER:**

From the iron pipe monument,

**NEW BEARING OBJECTS:**

A 5/8" x 30" iron pin bears North 39°53' East, a distance of 15.36 feet, with 1 1/2" aluminum cap marked BGB SURVEY MARKER NE RP.

A 5/8" x 30" iron pin bears South 28°40' East, a distance of 16.87 feet, with 1 1/2" aluminum cap marked BGB SURVEY MARKER SE RP.

A 5/8" x 30" iron pin bears South 26°08' West, a distance of 14.86 feet, with 1 1/2" aluminum cap marked BGB SURVEY MARKER SW RP.


A 5/8" x 30" iron pin bears North 70°29' West, a distance of 13.35 feet, with 1 1/2" aluminum cap marked BGB SURVEY MARKER NW RP.

I hereby certify that the corner was perpetuated on July 18, 2014.

Witness: Thomas J. Kopp



Renewal Date: June 30, 2015

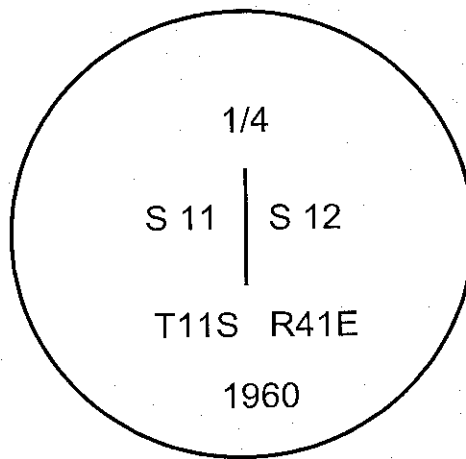

I used a Leice GS-15 RTK GPS in the establishment of the new accessories. Basis of bearing is a per survey for Hancock Forest Management, dated Aug. 2014. Bearings and distances are to the center of the aluminum cap. I use a steel tape and magnetic compass in the recovery of the bearing tree. I use 16° East declination.

FILED Aug. 11, 2014  
BAKER COUNTY SURVEYOR  
SURVEY NO. 11-41-63