

CERTIFIED RECORD OF LAND CORNER MONUMENTATION

HISTORY OF ORIGINAL CORNER ESTABLISHED:

Corner originally established by Benjamin F. Vaughn under GLO Contract No. 211, dated July 1874.
Survey General record states:


Set stone 14x12x10 for cor. to Secs. 13, 14, 23 and 24.

Corner reset at proportionate position by C. Albert White in dependent resurvey, completed under special instructions dated September 3, 1940, Group No. 261. Field notes state:

Set and iron post, 28 ins. long, 2 ½ ins. diam., 22 ins. in the ground with brass cap. From which:

- A yellow pine, 8 ins. diam., bears N. 25 ½° E., 12 lks. dist., mkd. T11S R41E S13 BT.
- A yellow pine, 5 ins. diam., bears S. 55 ½° E., 12 ½ lks. dist., mkd. T11S R41E S24 BT.
- A yellow pine, 12 ins. diam., bears S. 83 ½° W., 17 ½ lks. dist., mkd. T11S R41E S23 BT.
- A yellow pine, 7 ins. diam., bears N. 49 ½° W., 38 lks. dist., mkd T11S R41E S14 BT.

T 11 S R 41 E N-21

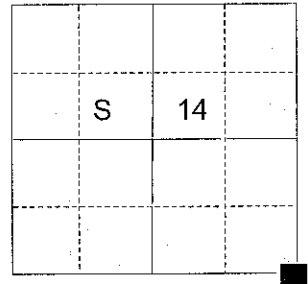

DESCRIPTION OF CORNER EVIDENCE FOUND:

Found a 2 ½" iron pipe with a 3" brass cap, marked as shown below, 2" above ground, in a collar of stone, 1.5 ft. diam., from which:

- A 7 inch Ponderosa Pine bears South 55° East, a distance of 8.3 feet, alive and vigorous with scribe marks visible on a partially healed blaze.
- A 16 inch Ponderosa Pine bears South 83° West, a distance of 11.6 feet, alive and vigorous with a healed blaze.

DESCRIPTION OF MONUMENT AND ACCESSORIES I ESTABLISHED

TO PERPETUATE THE ORIGINAL LOCATION OF THIS CORNER:

From the iron pipe monument,

NEW BEARING OBJECTS:

- An 8 inch Ponderosa Pine bears North 14° East, a distance of 12.15 feet, marked T11S R41E S13 BT.
- An 11 inch Ponderosa Pine bears North 76° West, a distance of 38.20 feet, marked T11S R41E S14 BT.


I hereby certify that the corner was perpetuated on July 18, 2014.

Witness: Thomas J. Kopp

REGISTERED
PROFESSIONAL
LAND SURVEYOR

OREGON
June 2, 2010
JEFFREY S. HSU
83571

Renewal Date: June 30, 2015

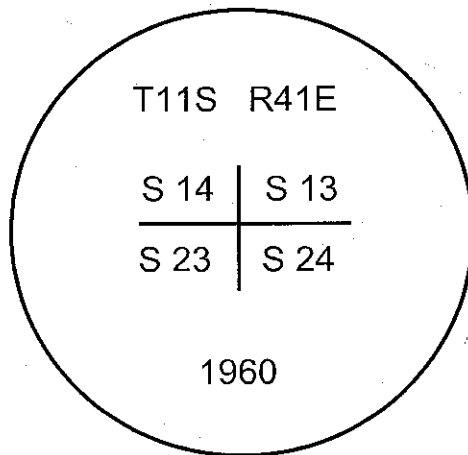

I use a steel tape and magnetic compass in the establishment of the bearing trees. I use 16° East declination. Distances are to a 60d spike in the right hand side of the root crown of the trees. Bearings are to a brass washer marked OPLS 83571 in the lower blaze.

FILED Aug. 11, 2014
BAKER COUNTY SURVEYOR
SURVEY NO. 11-41-66