

**CERTIFIED RECORD OF LAND CORNER MONUMENTATION**

**HISTORY OF ORIGINAL CORNER ESTABLISHMENT:**


Originally established by Benjamin F. Vaughn under GLO Contract No. 211, dated July 14, 1874. Surveyor record states:

Set stone 15x9x7 for 1/4 sec cor.

Corner established at proportionate position by C. Albert White under special instructions dated September 3, 1940, included under Group No. 261. Surveyor record states:

Set an iron post, 28 ins. Long, 2 1/2 ins. diam., 26 ins. in the ground with brass cap. From which:

- A yellow pine, 10 ins. diam., bears N. 22° E., 11 1/2 lks. dist., mkd. 1/4 S16 BT.
- A yellow pine, 5 ins. diam., bears N. 86 1/2° W., 30 lks. dist., mkd. 1/4 S17 BT.

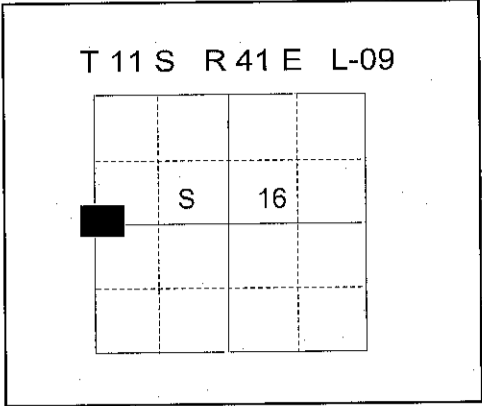

**DESCRIPTION OF CORNER EVIDENCE FOUND:**

Found 2 1/2" iron pipe with 3" Bureau of Land Management Brass cap, marked as shown below, 1" above the ground. No evidence of bearing trees remains.

**DESCRIPTION OF MONUMENT AND ACCESSORIES I ESTABLISHED TO PERPETUATE THE ORIGINAL LOCATION OF THIS CORNER:**

From the Iron Pipe position,

**NEW BEARING OBJECTS:**

- A 6 inch Ponderosa Pine bears N 46° E, a distance of 8.30 feet, marked 1/4 S16 BT.
- A 5 inch Ponderosa Pine bears S 73° E, a distance of 11.15 feet, marked 1/4 S16 BT.
- A 10 inch Ponderosa Pine bears S 30° W, a distance of 17.90 feet, marked 1/4 S17 BT.
- A 7 inch Ponderosa Pine bears N 50° W, a distance of 9.05 feet, marked 1/4 S17 BT.

Set a steel fencepost approximately 0.5 feet North of corner monument.

I hereby certify that the corner was perpetuated on October 14, 2014.


Witness: Thomas J. Kopp

REGISTERED  
PROFESSIONAL  
LAND SURVEYOR



OREGON  
June 2, 2010  
JEFFERY S. HSU  
83571

Renewal Date: June 30, 2013

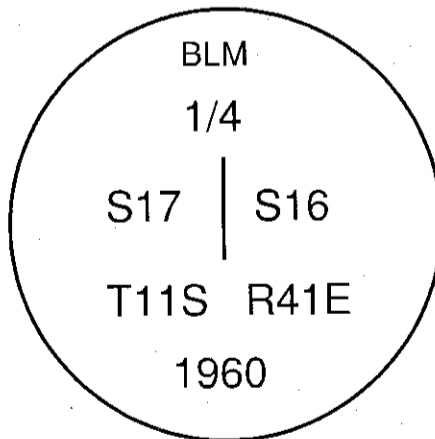

I used a steel tape and magnetic compass in the establishment of the new accessory. I used 16° East declination, the distances are to a 60d spike driven into the right side of the root crown of the new bearing tree. A brass washer marked OPLS 83571 is attached to the BT blaze of the new bearing trees.