

CERTIFIED RECORD OF LAND CORNER MONUMENTATION

HISTORY OF ORIGINAL CORNER ESTABLISHMENT:

Originally established by Benjamin F. Vaughn under GLO Contract No. 211, dated July 14, 1874. Surveyor record states:


Set stone 16x10x10 for cor to secs 16-17-20 and 21.
From Which:

A Pine 15 in Dia Bears N45°E 200 lks Dist.

Corner established at proportionate position by C. Albert White under special instructions dated September 3, 1940, included under Group No. 261. Surveyor record states:

Set an iron post, 28 ins. Long, 2 ½ ins. diam., 24 ins. in the ground with brass cap. From which:

- A yellow pine, 16 ins. diam., bears N. 68° E., 55 lks. dist., mkd. T11S R41E S16 BT.
- A yellow pine, 13 ins. diam., bears S. 75½° E., 35 lks. dist., mkd. T11S R41E S21 BT.
- A yellow pine, 12 ins. diam., bears S. 30½° W., 24 lks. dist., mkd. T11S R41E S20 BT.
- A yellow pine, 15 ins. diam., bears N. 42½° W., 30 lks. dist., mkd. T11S R41E S17 BT.

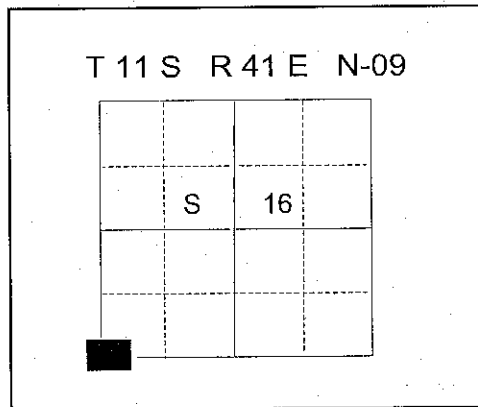

DESCRIPTION OF CORNER EVIDENCE FOUND:

Found 2 ½" iron pipe with 3" Bureau of Land Management Brass cap, marked as shown below, 2" above the ground. From which:

Found a 30" Ponderosa Pine Stump bears N. 68° E., a distance of 37 feet with healed blaze evident.

Found a tree dead and down, the stump hole which bears S. 30° W., a distance of approximately 16 feet. Tree is decayed, the original size cannot be ascertained.

DESCRIPTION OF MONUMENT AND ACCESSORIES I ESTABLISHED

TO PERPETUATE THE ORIGINAL LOCATION OF THIS CORNER:

From the iron pipe monument,

NEW BEARING OBJECTS:

- A 17" Western Larch bears N 25° E, a distance of 38.60 feet, marked T11S R41E S16 BT.
- A 11" Ponderosa Pine bears S 16° E, a distance of 30.90 feet, marked T11S R41E S21 BT.
- A 8" Ponderosa Pine bears S 80° W, a distance of 40.15 feet, marked T11S R41E S20 BT.
- A 6" Western Larch bears N 71° W, a distance of 23.10 feet, marked T11S R41E S17 BT.

I hereby certify that the corner was perpetuated on October 14, 2014.


Witness: Thomas J. Kopp

REGISTERED
PROFESSIONAL
LAND SURVEYOR



OREGON
June 2, 2010
JEFFERY S. HSU
83571

Renewal Date: June 30, 2013

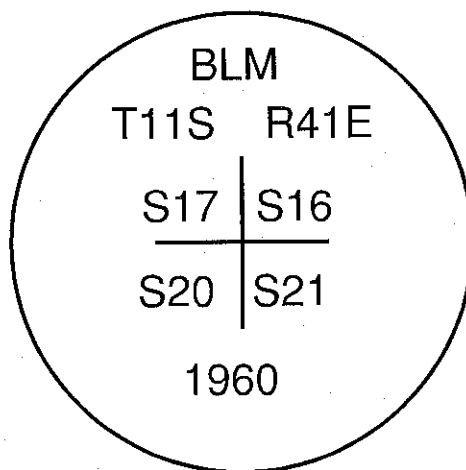

I used a steel tape and magnetic compass in the establishment of the new accessory. I used 16° East declination, the distances are to a 60d spike driven into the right side of the root crown of the new bearing tree. A brass washer marked OPLS 83571 is attached to the BT blaze of the new bearing trees.

FILED December 11, 2014
BAKER COUNTY SURVEYOR
SURVEY NO. 11-41-68