


CERTIFIED RECORD OF LAND CORNER MONUMENTATION

Index #N-9

History of original corner establishment:

The original corner was set by Benj. F. Vaughan under GLO contract no. 211, dated July 14, 1874, as part of a subdivisional survey of T. 11 S., R. 43 E., W.M.

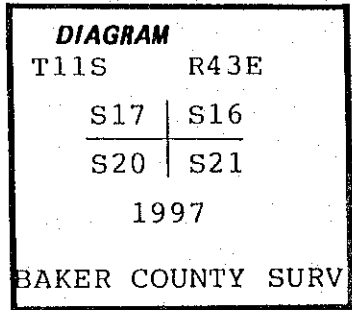

The original notes state: Set stone 20x8x6 for cor. to secs. 16,17,20 and 21.

Description of corner evidence found:

Found a basalt stone 17"x12"x6" laying in a 2 ft. dia. stone mound with a steel fence post set alongside. The stone has 3 chisled notches on one corner and 4 chisled notches on another.

Description of monument and accessories I established to perpetuate the original location of this corner:


At the position of the found corner stone set a 1 1/4"x30" galv. pipe with a 2 1/2" dia. brass cap 20" into the ground with a 2' dia. stone mound surrounding it. Buried the GLO stone 1 ft. North of the new monument and set a steel fence post alongside. The brass cap is marked as shown in the corner diagram.

Corner monument references: Four 1"x2 1/2" magnets encased in plastic were set 6" below the ground. From the corner monument:

- A silver magnet mkd. "1" bears N. 50° E., 9.6 ft. dist.
- A pink magnet mkd. "2" bears S. 51° E., 11.0 ft. dist.
- A blue magnet mkd. "3" bears S. 50° W., 8.5 ft. dist.
- A orange magnet mkd. "4" bears N. 51° W., 9.4 ft. dist.

Compass declination 19°.

Reference survey: CS 11-43-7

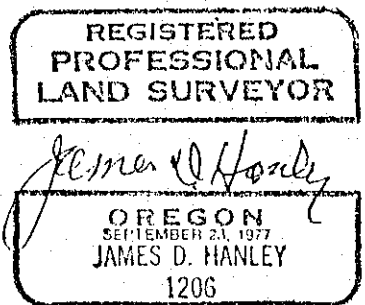

I James D. Hanley certify that this corner was properly remonumented as witnessed by Larry McBroom and Dan Lees on Feb. 28, 1997.

Office of..... County of.....
 State of....., I hereby certify that the within instrument was filed in this office
 for record on the..... day of....., 19.....
 by
 (COUNTY OFFICIAL) (DEPUTY)

Form R6-7100-57 (9/71)

FILED 2-28-97
 BAKER COUNTY SURVEYOR
 SURVEY NO. CP# 47
11-43-30