


RECORD OF SURVEY
SE 1/4 SEC. 20, T.11S., R.43E., W.M.
BAKER COUNTY, OREGON

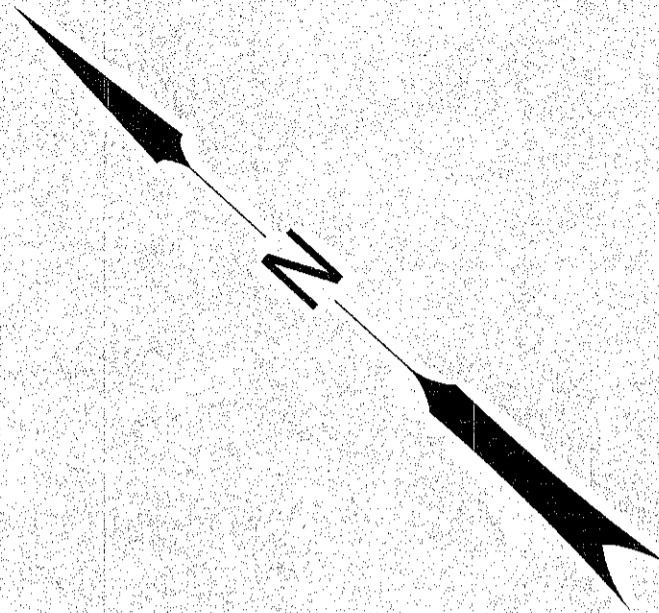

D. A. Hindman
Book 121, Page 354

1174+54.07
N. 107499.431
E. 2740508.784

35+800.000 P.O.T.

35+900

36+000

9.144m
(307)

OLD U.S. 30

9.144m
(307)

S42°09'47"E

9.144m
(307)

(COUNTY ROAD NO. 539)

S39°50'E

9.144m
(307)

MATCH SHEET 3

D. A. Hindman
Book 140, Page 91


LEGEND

- MONUMENT FOUND AS NOTED IN TABLE.
- ▲ PROJECT CONTROL POINT FOUND OR SET AS NOTED IN TABLE.
- CALCULATED POSITION
- EXISTING PAVEMENT
- N 70°46'22"E MEASURED INFORMATION
- N 69°01'30" E RECORD INFORMATION



NOTE:
ALL DIMENSIONS ARE
IN METERS EXCEPT
AS NOTED.

SCALE RATIO 1:500

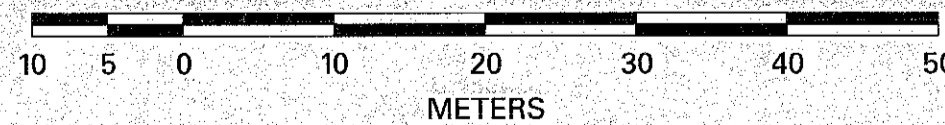

REGISTERED
PROFESSIONAL
LAND SURVEYOR

OREGON
JULY 21, 1992
WAYNE R. DONOVAN
2553

RENEWAL DATE: DEC. 31, 2003
SIGNED: April 25, 2002



CONSULTING
ENGINEERS

920 COUNTRY CLUB RD., SUITE 100B
EUGENE, OREGON 97401
TEL. (541) 683-6090 FAX. (541) 683-6576

CENTER LINE RESOLUTION,
MONUMENT RECOVERY AND CONTROL SURVEY
PRITCHARD CREEK BRIDGE SEC.
OLD U.S. 30
FOR BAKER COUNTY AND
OREGON DEPARTMENT OF TRANSPORTATION
MARCH 16, 2002

SCALE 1:500

POINT TABLE

POINT NO.	DESCRIPTION	REFERENCE	DATE FOUND/SET	OFFSET	STATION	NORTHING	EASTING
140	SET MAG NAIL & WASHER IN HUB "OBEC CONTROL"	OBEC CONTROL	2/27/2002	4.891 R	35+972.454	107368.318	2740620.917

M.L. Armstrong, CAP. Surveyor
APPROVED BY: TITLE

DESIGNED: W. DONOVAN
DRAWN: AD
CHK'D: DEW
PROJ. NO. 19-66.3
FILE NO. 11707 S
SHT. 2 OF 5

04/25/2002
I:\Projects\019\01906603\Cad\Map\01906603.rle.dwg