

RECORD OF SURVEY
SE 1/4 SEC. 20, T.11S., R.43E., W.M.
BAKER COUNTY, OREGON

M.K. & J.L. HINDMAN
DEED 78 37 035

LEGEND	
●	SET RIGHT OF WAY MONUMENT AS NOTED IN TABLE
▲	PROJECT CONTROL POINT FOUND AS NOTED IN TABLE
□	CALCULATED POSITION
N 70°46'22"E	MEASURED INFORMATION
(*)	RECORD INFORMATION
*	SAME AS RECORD
**	OUTSIDE MAPPING LIMITS

35+800.000 P.O.T. (1)*
1174+54.07
N. 107499.431
E. 2740508.784

36+200

PRITCHARD CREEK

D. A. HINDMAN
BOOK 121, PAGE 354

BOOK 03 17, PAGES 0191-0195 & 0055-0058

BRIDGE NO. 00741

NORTH LINE SW 1/4 SE 1/4 PER S.N. 11-43-9

MATCH SHEET 3

36+400

OLD U.S. 30

S42°09'47"E (1)*

(COUNTY ROAD NO. 539)



D. A. HINDMAN
BOOK 140, PAGE 91

BOOK 03 17,
PAGE 0196-0199

BOOK 03 17,
PAGE 0191-0195

M.K. & J.L. HINDMAN
DEED 78 37 035

SCALE RATIO 1:500

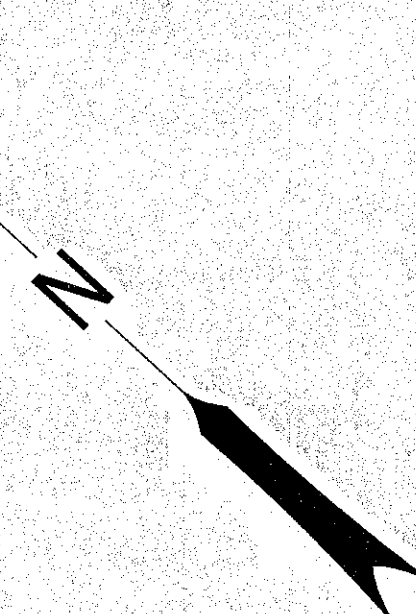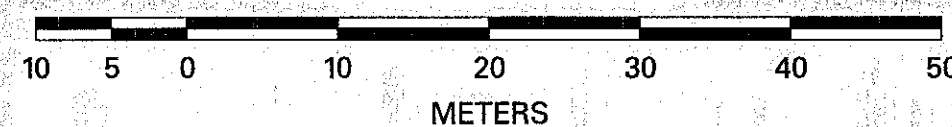

FILED DECEMBER 8, 2003

BAKER COUNTY SURVEYOR
SURVEY NO. 11-43-14



NOTE:
ALL DIMENSIONS ARE
IN METERS EXCEPT
AS NOTED.

MONUMENT LIST

PT. NO.	LDP NORTHING	LDP EASTING	DATE FOUND/SET	STATION	OFFSET	DESCRIPTION
130	107138.601	2740841.218	9/17/03	36+290.604	4.209 LT.	FOUND 16mm X 762mm IRON ROD W/RPC "OBEC CONTROL"
**140	107368.318	2740620.917	9/17/03	35+972.454	4.891 RT.	FOUND MAG NAIL & WASHER IN HUB "OBEC CONTROL"
150	107068.620	2740904.570	9/17/03	36+385.001	4.194 LT.	FOUND MAG NAIL & WASHER IN HUB "OBEC CONTROL"
5000	107142.362	2740844.470	9/17/03	36+290.000	9.144 LT.	SET 16mm X 762mm IRON ROD W/YPC MARKED "OBEC PLS 2553"
5001	107136.866	2740853.300	9/17/03	36+300.000	12.000 LT.	CALCULATED POSITION - NO MONUMENT SET
5002	107120.124	2740864.608	9/17/03	36+320.000	9.144 LT.	CALCULATED POSITION - NO MONUMENT SET
5003	107122.674	2740837.627	9/17/03	36+300.000	9.144 RT.	SET 16mm X 762mm IRON ROD W/YPC MARKED "OBEC PLS 2553"
5004	107117.722	2740839.608	9/17/03	36+305.000	11.000 RT.	SET 16mm X 762mm IRON ROD W/YPC MARKED "OBEC PLS 2553"
5005	107069.541	2740883.238	9/17/03	36+370.000	11.000 RT.	SET 16mm X 762mm IRON ROD W/YPC MARKED "OBEC PLS 2553"
5006	107067.081	2740887.970	9/17/03	36+375.000	9.144 RT.	SET 16mm X 762mm IRON ROD W/YPC MARKED "OBEC PLS 2553"

REGISTERED
PROFESSIONAL
LAND SURVEYOR

OREGON
JULY 21, 1992
WAYNE R. DONOVAN
2553

RENEWAL DATE: DEC. 31, 2003
SIGNED: *Wayne R. Donovan*



CONSULTING
ENGINEERS

920 COUNTRY CLUB RD., SUITE 100B
EUGENE, OREGON 97401
TEL. (541) 683-6090 FAX. (541) 683-6576

RIGHT-OF-WAY BOUNDARY MONUMENTATION MAP
PRITCHARD CREEK BRIDGE SEC.
OLD U.S. 30

FOR BAKER COUNTY AND
OREGON DEPARTMENT OF TRANSPORTATION
DECEMBER, 2003

SCALE 1:500

M. ARMSTRONG OBEC
APPROVED BY: CHF. SURVEYOR TITLE

DESIGNED: W. DONOVAN
DRAWN: AD
CHK'D: MLA
PROJ. NO. 19-66.3F
FILE NO. 12765 S
SHT. 2 OF 3

12/01/2003

\\pfs\projects\019\090603\SURVEY\CAD\090603rw_mon.dgn