

RECORD OF SURVEY  
SE 1/4 SEC. 20, T.11S., R.43E., W.M.  
BAKER COUNTY, OREGON

M.K. & J.L. HINDMAN  
DEED 78 37 035

M.K. & J.L. HINDMAN  
DEED 78 37 035

MATCH SHEET 2

NORTH LINE SW 1/4 SE 1/4 PER S.N. 11-43-9

36+400

36+500

OLD U.S. 30

(COUNTY ROAD NO. 539)



S42°09'47"E (1)\*

M.K. & J.L. HINDMAN  
DEED 78 37 035

CREEK

**LEGEND**

- SET RIGHT OF WAY MONUMENT AS NOTED IN TABLE
- ▲ PROJECT CONTROL POINT FOUND AS NOTED IN TABLE
- CALCULATED POSITION
- N 70°46'22"E MEASURED INFORMATION
- (\*) RECORD INFORMATION
- \* SAME AS RECORD
- \*\* OUTSIDE MAPPING LIMITS

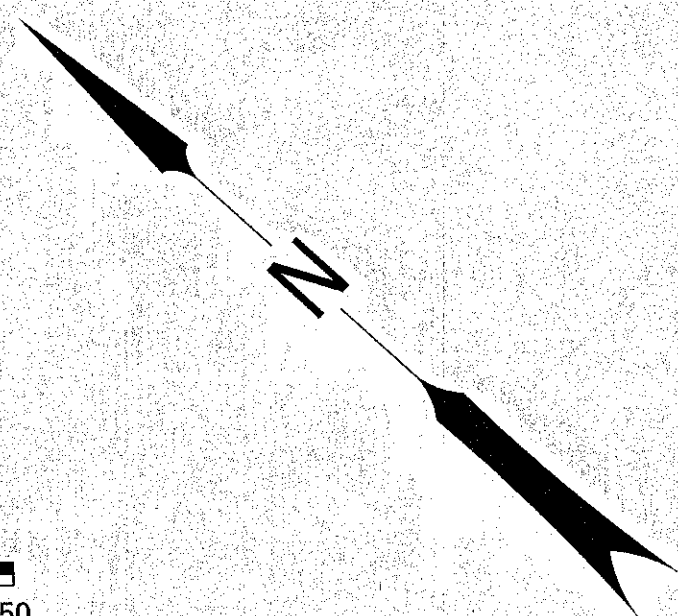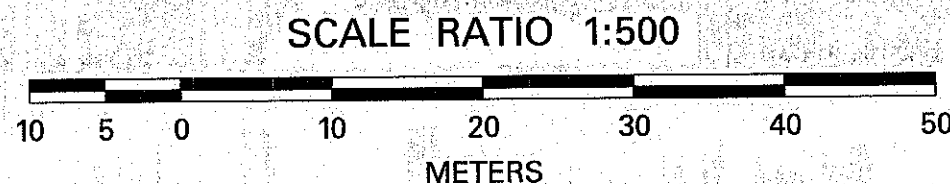

FILED DECEMBER 8, 2003  
BAKER COUNTY SURVEYOR  
SURVEY NO. 11-43-14



NOTE:  
ALL DIMENSIONS ARE  
IN METERS EXCEPT  
AS NOTED.

MONUMENT LIST

PT. NO.	LDP NORTHING	LDP EASTING	DATE FOUND/SET	STATION	OFFSET	DESCRIPTION
110	106925.448	2741033.911	9/17/03	36+577.683	4.721 LT.	FOUND 16mm X 762mm IRON ROD W/RPC "OBEC CONTROL"
150	107068.620	2740904.570	9/17/03	36+385.001	4.194 LT.	FOUND MAG NAIL & WASHER IN HUB "OBEC CONTROL"
5005	107069.541	2740883.238	9/17/03	36+370.000	11.000 RT.	SET 16mm X 762mm IRON ROD W/YPC MARKED "OBEC PLS 2553"
5006	107067.081	2740887.970	9/17/03	36+375.000	9.144 RT.	SET 16mm X 762mm IRON ROD W/YPC MARKED "OBEC PLS 2553"

REGISTERED  
PROFESSIONAL  
LAND SURVEYOR

OREGON  
JULY 21, 1992  
WAYNE R. DONOVAN  
2553

RENEWAL DATE: DEC. 31, 2003  
SIGNED: 12/08/03



CONSULTING  
ENGINEERS

920 COUNTRY CLUB RD., SUITE 100B  
EUGENE, OREGON 97401  
TEL. (541) 683-6090 FAX. (541) 683-6576

RIGHT-OF-WAY BOUNDARY MONUMENTATION MAP  
PRITCHARD CREEK BRIDGE SEC.  
OLD U.S. 30

FOR BAKER COUNTY AND  
OREGON DEPARTMENT OF TRANSPORTATION

DECEMBER, 2003

SCALE 1:500

M. ARMSTRONG	OBEC	DESIGNED: W. DONOVAN	PROJ. NO. 19-66.3F	SHT. 3 OF 3
APPROVED BY: CHF. SURVEYOR TITLE		DRAWN: AD	CHK'D: MLA	FILE NO. 12766 S

12/01/2003 I:\Projects\OB\106603\SURVEY\CAD\106603.rvt\_mon.dgn