

SURVEY NARRATIVE – Sheet 1 of 2

To: Baker County Surveyor
Tom Hanley, P.L.S.
2043 Main St, Baker City, OR 97814

From: Anderson Perry & Associates, Inc.
1901 N. Fir Street, La Grande, Oregon 97850

RE: K19785 - ODOT I-84 Cable Median Barrier Project in Morrow County, Oregon
Post-Construction Monument Restoration – SE 1/4, Sec. 34, T. 11 S., R. 43 E., W.M.

Date: August 20, 2020

Job/File No.: 863-158 (070.4)

Purpose, Approach, and Equipment

During the ODOT I-84 Cable Median Barrier Project, Anderson Perry & Associates, Inc. (AP) was tasked with recovering ODOT I-84 centerline brass cap monuments that mark and control the right of way alignment of the I-84 corridor through Baker County, Oregon. The pre-construction monument recovery survey was completed in 2018 in preparation for project construction. The newly constructed cable median barriers divide the east-bound from the west-bound travel lanes of I-84 for enhanced safety. A post-construction monument recovery survey was started in fall 2019 and completed during summer 2020, after construction was complete, to determine if any of the monuments in question had been disturbed or destroyed. In Baker County, five monuments were found to have been destroyed. A separate Survey Narrative will be filed for each point in Baker County Survey Records. This Survey Narrative details the re-monumentation effort in the Southeast One-Quarter of Section 34, Township 11 South, Range 43 East, Willamette Meridian.

Along the entire project corridor, which extended through five counties in eastern Oregon, 287 monuments were searched for and 244 monuments were recovered. The monuments were located with GPS in real-time kinematic (RTK) mode utilizing the Oregon Real Time GNSS Network (ORGN) administered by ODOT. The Oregon Coordinate Reference System (OCRS), Baker Zone, NAD83(2011) Epoch 2010 (EPSG Code 6787 for reference) was used for the portion of the project in Baker County. For each monument location, an additional ORGN observation was completed as a double check on the original monument location. The results of the double checks were compared to the original locations and used to verify that positional accuracies were adequate to meet the project specifications. The monument recovery was accomplished using Trimble R10 or R2 dual frequency GPS receivers in RTK mode.

FILED September 29, 2020
BAKER COUNTY SURVEYOR
SURVEY NO. 11-43-26 page 1 of 2

Monument Restoration – Sheet 2 of 2

For the monument restoration portion of the project, the available ODOT survey records were researched for each existing centerline monument within the project footprint in Baker County, specifically, their origin, type, size, and character and other relevant information, in preparation for setting the replacement monuments, in the event that they were disturbed or destroyed. That information for the monument in the SE 1/4, Sec. 34, T. 11 S., R. 43 E., W.M. is described in detail as follows:

History of Original Centerline Monument

The ODOT Centerline Monument set on Oregon State Highway Department located Line Drawing Number 8B-29-1 dated July 1963 describes "Set Mon" indicates set brass disk in concrete monument at the record Centerline Station of 1347+26.27.

Description of Monument Found

Found a 2-3/4" diameter brass cap set in concrete, flush with the ground, stamped "STATE HIGHWAY DEPARTMENT REFERENCE POT EB 1347+26.27 50.00" and a steel post with a metal highway right of way paddle 2.50' north of the monument.

Description of Monument Established to Perpetuate the Original Position

The original monument has been destroyed by construction activities. At the position of the original monument, AP set a 3-1/2" diameter aluminum cap with a 3" long post, in an 8" diameter x 2' long concrete base, set flush with the ground. The aluminum cap is stamped "EB POT 1347+26.27 50.00" and marked as shown. A piece of 5/8" diameter rebar was also placed inside the concrete base to aid in recovery.



Horizontal Coordinate System Used

OCRS BAKER Zone, NAD83(2011) Epoch2010, (EPSG Code 6787 for reference) Expressed in International Feet

Northing	Easting
22266.91	236699.38

I hereby certify that the above monument position was perpetuated as hereon described on August 20, 2020.
Witnesses: Casey Boyd and Ryan Hays

SE 1/4 SECTION 34

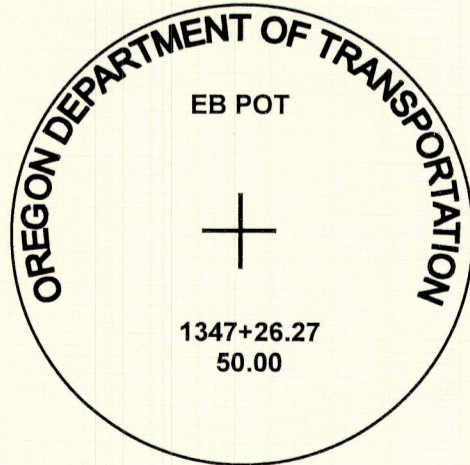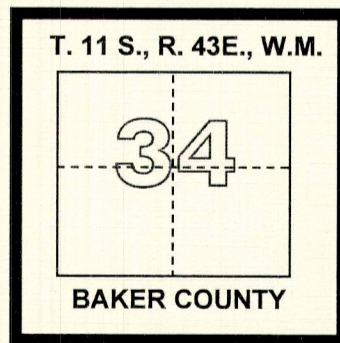

REGISTERED PROFESSIONAL LAND SURVEYOR

Michael B. Posada
OREGON
JANUARY 20, 1998
MICHAEL B. POSADA
2849LS

EXPIRES: 12-31-2020
SIGNED: 09-10-2020

FILED September 29, 2020
BAKER COUNTY SURVEYOR
SURVEY NO. 11-43-26 page 2 of 2