


CERTIFIED RECORD OF LAND CORNER MONUMENTATION

**History of original corner establishment:**

Corner established by Herman D Gradon under GLO contract no. 428 and dated Dec. 16, 1881.

**Surveyor General records state:**

Set a basalt stone 20 x 12 x 5 ins 15 ins in the ground for 1/4 sec cor marked 1/4 on west face, dug pits 18 x 18 x 12 ins north and south of stone 5 1/2 feet distance and raised mound of earth 1 1/2 feet high and 4 1/2 feet base alongside.

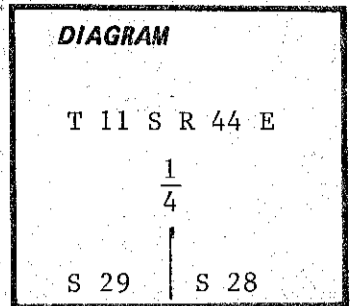


**Description of corner evidence found:**

Found a stone 21 x 11 x 6 inches firmly set 12 inches in the ground and marked 1/4 on the east side in an old fence corner from which the fence bears north, south and east.

**Description of monument and accessories I established to perpetuate the original location of this corner:**

Set a 2 1/2 inch brass cap on a 1 inch iron pipe 31 inches long and projecting 6 inches out of the ground with a surrounding rock mound. Buried original stone 1 foot east.

Brass cap marked thus:

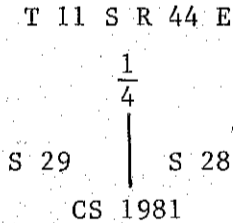

I hereby certify that the above described corner monument was properly established under my direct supervision on Sept. 4, 1981, and witnessed by Jim DeMastus and Dick D'Ewart

REGISTERED  
PROFESSIONAL  
LAND SURVEYOR

*James D. Hanley*

OREGON  
SEPTEMBER 23, 1977  
JAMES D. HANLEY  
1206

Office of..... County of.....  
 State of....., I hereby certify that the within instrument was filed in this office  
 for record on the..... day of....., 19.....  
 ..... by .....  
 (COUNTY OFFICIAL) (DEPUTY)

Form R6-7100-57 (9/71)

FILED Oct 16, 1981  
 BAKER COUNTY SURVEYOR  
 SURVEY NO. 11-44-5