


CERTIFIED RECORD OF LAND CORNER MONUMENTATION

History of original corner establishment:

Corner established by Herman D. Gradon under GLO contract no. 428 and dated Dec. 16, 1881.

Surveyor General records state:

Set a basalt stone 14 x 10 x 5 ins 9 ins in the ground for 1/4 sec cor marked 1/4 on west side, dug pits 18 x 18 x 12 ins north and south of stone 5 1/2 feet dist. and raised mound of earth 1 1/2 feet high 3 1/2 feet base.

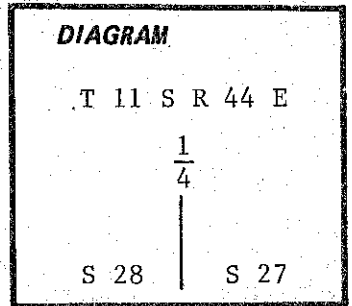

Description of corner evidence found:

Found a stone 15 x 10 x 5 inches firmly set 10 inches in the ground and marked 1/4 on the west side.

Description of monument and accessories I established to perpetuate the original location of this corner:

Set a 2 1/2 inch brass cap on a 1 inch iron pipe 31 inches long and projecting 6 inches out of the ground with a surrounding rock mound. Buried original stone 1 foot north of brass cap.

Brass cap marked thus:

T 11 S R 44 E

1/4

S 28 | S 27

CS 1981

I hereby certify that the above described corner monument was properly established under my direct supervision on Sept. 4, 1981, and witnessed by Jim DeMastus and Dick D'Ewart.

REGISTERED
PROFESSIONAL
LAND SURVEYOR

James D. Hanley

OREGON
SEPTEMBER 23, 1977
JAMES D. HANLEY
1206

Office of..... County of.....

State of....., I hereby certify that the within instrument was filed in this office for record on the..... day of....., 19.....

..... by

(COUNTY OFFICIAL)

(DEPUTY)

Form R6-7100-57 (9/71)

FILED Oct 16, 1981

BAKER COUNTY SURVEYOR

SURVEY NO. 11-44-7