


CERTIFIED RECORD OF LAND CORNER MONUMENTATION

History of original corner establishment:

Corner established by Herman D. Gradon under GLO contract no. 428 and dated Dec. 16, 1881.

Surveyor General records state:

Set a basalt stone 22 x 12 x 3 ins 15 ins in the ground for sec cor to secs 28, 29, 32 and 33 marked with 1 notch on S and 4 notches on E edges and raised mound of stone alongside.

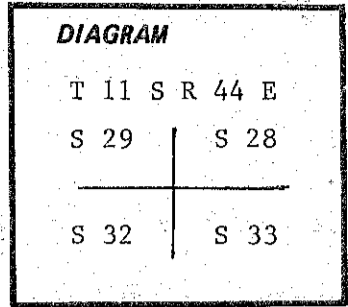


Description of corner evidence found:

Found a stone 26 x 13 x 3 inches in an old fence corner marked with 1 notch on south and 3 notches on east edges. Fence line bears north and west.

Description of monument and accessories I established to perpetuate the original location of this corner:

Set a 2½ inch brass cap on a 1 inch iron pipe 31 inches long and projecting 6 inches out of the ground with a surrounding rock mound. Buried original stone 1 foot south of brass cap.

Brass cap marked thus:

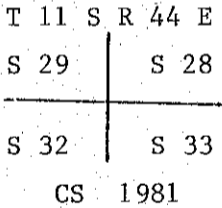

I hereby certify that the above described corner monument was properly established under my direct supervision on Sept. 11, 1981, and witnessed by Jim DeMastus and Dick D'Ewart

REGISTERED PROFESSIONAL LAND SURVEYOR

James D. Hanley

OREGON SEPTEMBER 23, 1977 JAMES D. HANLEY 1206

Office of..... County of.....
 State of....., I hereby certify that the within instrument was filed in this office
 for record on the..... day of....., 19.....
 by
 (COUNTY OFFICIAL) (DEPUTY)

Form R6-7100-57 (9/71)

FILED Oct 16 1981
 BAKER COUNTY SURVEYOR
 SURVEY NO. 11-44-9