


CERTIFIED RECORD OF LAND CORNER MONUMENTATION

History of original corner establishment:

Corner was established in 1882, under Contract No. 428, by Herman Gradon deputy surveyor. At the $\frac{1}{4}$ corner common to sections 33 and 34, T 11 S, R 44 E WM, he set a basalt stone 17" x 9" x 6", 10 inches in the ground, for the $\frac{1}{4}$ sec. cor. marked $\frac{1}{4}$ on the west face and a raised mound of stone along side.

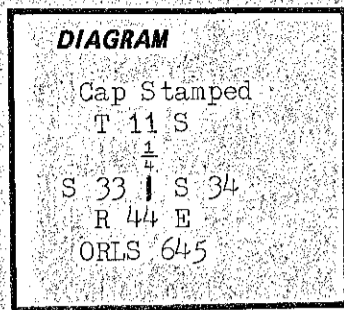

Description of corner evidence found:

At the above mentioned $\frac{1}{4}$ corner location I found a basalt stone 18" x 9" x 7" about 10 inches in the ground with $\frac{1}{4}$ marked on the west face, with a mound of stone along side about 4 feet to the west of stone. Also there is a rock jack and fence corner 2 feet to the north of the stone.

Description of monument and accessories I established to perpetuate the original location of this corner:

After evaluating the evidence I found at the assumed $\frac{1}{4}$ corner location, I found the evidence to agree with the original GLO notes, therefore I placed a brass cap on a 1" x 30" galv. iron pipe at the location of the above mentioned stone. I placed the marked stone in the hole upside down, with the $\frac{1}{4}$ marking, facing the iron pipe and being along the west edge of the pipe. I then buried the stone in a large mound of stone about the pipe approx. $3\frac{1}{2}$ feet in diameter and $1\frac{1}{2}$ feet high, with the brass cap flush to the surface of the mound. The brass cap is stamped as shown above.

REGISTERED
PROFESSIONAL
LAND SURVEYOR

James H. Hambleton

OREGON
JULY 10, 1964
JAMES H. HAMBLETON
645

Office of..... County of.....
State of....., I hereby certify that the within instrument was filed in this office
for record on the..... day of....., 19.....

(COUNTY OFFICIAL)

(DEPUTY)