


CERTIFIED RECORD OF LAND CORNER MONUMENTATION

History of original corner establishment:

Corner was established in 1882, under Contract No. 428, by Herman Gradon deputy surveyor. At the $\frac{1}{4}$ corner common to sections 32 and 33, T 11 S, R 44 E WM, he set a basalt stone 12" x 9" x 5", 8 inches in the ground, marked $\frac{1}{4}$ on the west face of stone and raised a mound of stone along side.

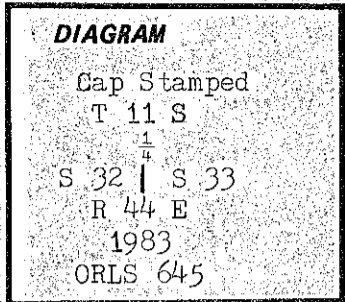

Description of corner evidence found:

At the above mentioned $\frac{1}{4}$ corner location I found a basalt stone 12" x 9" x 5", six inches in ground with $\frac{1}{4}$ marked on the west face of the stone. A raised mound of stone along side. Also a rock jack is located 4 feet east of stone and being next to a rock outcrop that is about 4 feet high.

Description of monument and accessories I established to perpetuate the original location of this corner:

After evaluating the evidence I found at the assumed $\frac{1}{4}$ corner location, I found the evidence agrees with the original GLO notes, therefore I placed a brass cap on a 1" x 30" galv. iron pipe at the location of the above mention stone. I placed the marked stone upside down, with the $\frac{1}{4}$ marking, facing the iron pipe and being along the west edge of the pipe. I then buried the stone in a large mound of stone about the pipe, approx. $3\frac{1}{2}$ feet in diameter and 2 feet high, with the brass cap flush to the surface of the mound. The brass cap is stamped as shown above.

REGISTERED
PROFESSIONAL
LAND SURVEYOR

James H. Hambleton

OREGON
JULY 10, 1964
JAMES H. HAMBLETON
645

Office of..... County of.....
State of..... I hereby certify that the within instrument was filed in this office
for record on the..... day of....., 19.....
..... by

(COUNTY OFFICIAL)

(DEPUTY)