

GOVERNMENT CORNER RECORD

Township 11S Range 45E Section 20/17 County BAKER

State OREGON Date 10/9/97 Number N-7

Corner Designation :

- Condition Report Only
- Not Found
- Renewed
- Surveyed In
- Referenced

Previous Renewals _____

Monument (s) Found: (Condition and Source)


FOUND U.S.G.L.O. BRASS CAP MONUMENT DATED 1938.
 BENT TO THE NORTH, BUT STILL FIRMLY IN GROUND.
 CORNER WAS STRAIGHTENED BACK TO VERTICAL POSITION.

Accessories Found:

FOUND 28" FIR STUMP & BLAZE S43' E, 13 LINKS,
 FOUND 24" FIR STUMP & BLAZE N73' E, 19 LINKS.
 FOUND REMAINS OF TAMARACK STUMP S 54' E, 40 LINKS.
 FOUND REMAINS OF TAMARACK STUMP N 32' W, 30 LINKS.

MONUMENT DETAIL

Found Set

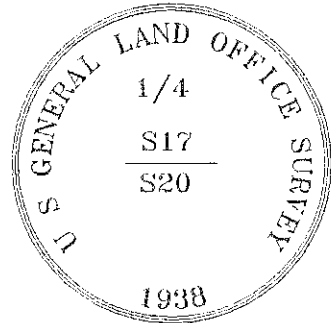

Monument & Accessories Set (Procedure and Description)

Sketch of Monument, Accessories and General Area

CORNER IS IN SKID TRAIL ON NORTH FACING SLOPE, APPROX. 150 FT. NORTH OF RIDGE TOP AT HEAD OF SKID TRAIL COMING UP RIDGE FROM NORTH. BUILT ROCK MOUND AROUND CORNER.



Surveyor's Seal

REGISTERED
PROFESSIONAL
LAND SURVEYOR

Danny K. Cummings
10-9-97

OREGON
JAN. 21, 1988
DANNY K. CUMMINGS
2316

RENEWAL DATE : 12-31-97

GASCHLER
& CUMMINGS

Agency _____

Party Chief D. CUMMINGS

Notekeeper L. KING

Witness(s) _____

FIELD BOOK #FB 0-143

COUNTY SURVEYOR RECORDING INFO

Received _____

Filed _____

Survey No. _____

Drawing No. _____

Index No. _____

FILED NOV. 25, 1997
 BAKER COUNTY SURVEYOR
 SURVEY NO. 11-45-8