


CERTIFIED RECORD OF LAND CORNER MONUMENTATION

History of original corner establishment:

Corner established by Eugene P. McCornack, under G.L.O. contract No. 598 dated July 2, 1881.

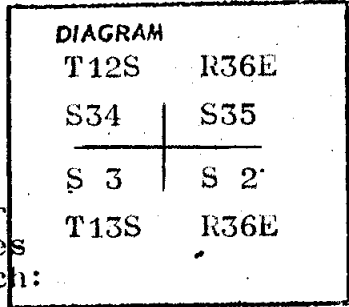

Surveyor's General record states:

Set a basalt stone 16"x12"x4", 11" in the ground for the corner to sections 2,3,34&35 marked with 2 notches on the east and 4 notches on the west faces from which:

- A pine 36" in diam. bears N65E 104 lks. marked T12SR36E S35 BT
- A pine 14" in diam. bears S50E 45 lks. marked T13SR36E S 2 BT
- A pine 36" in diam. bears S75W 134 lks. marked T13SR36E S 3 BT
- A pine 24" in diam. bears N 5W 136 lks. marked T12SR36E S34 BT


Description of corner evidence found:

Found original stone and bearing trees.

Description of monument and accessories established to perpetuate the original location of this corner

Set a 2 1/2" brass cap on a 2" iron pipe, 30" long.

Brass Cap marked Thus:

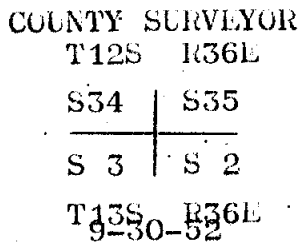

FILED Sept 30, 1952
 BAKER COUNTY SURVEYOR
 SURVEY NO. 12-36-1

Office of County surveyor County of Baker
 State of Oregon, I hereby certify that the within instrument was filed in this office
 for record on the day of
 by
 (COUNTY OFFICIAL) (DEPUTY)