


9160-2
v. 1964

UNITED STATES
DEPARTMENT OF THE INTERIOR
BUREAU OF LAND MANAGEMENT

TOWNSHIP DIAGRAM

SCALE: 1 INCH = 1 MILE

TOWNSHIP 12 SOUTH, RANGE 36 EAST, WILLAMETTE MER.
STATE OREGON

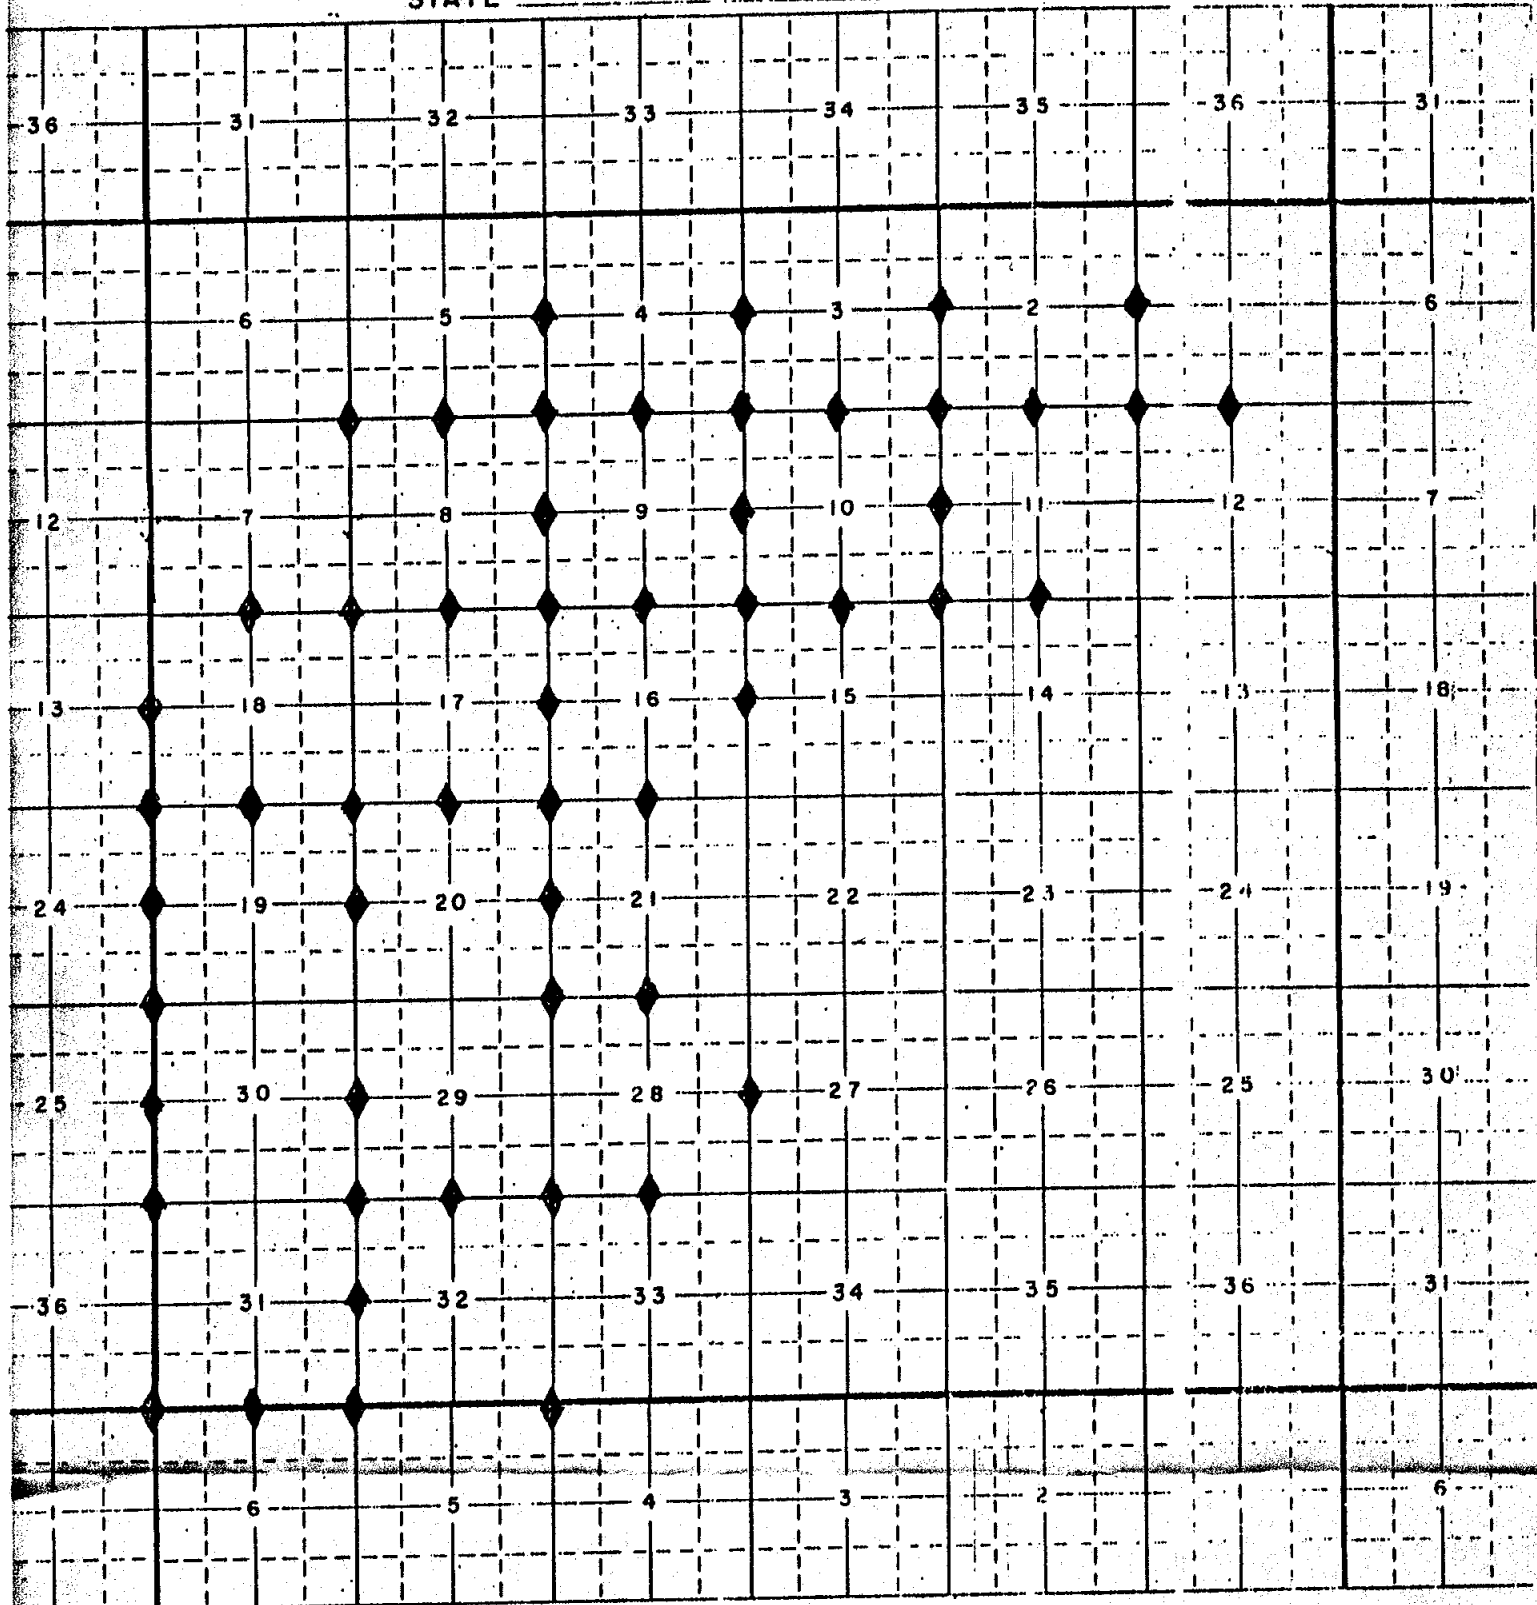

FIELD WORK DONE DURING FISCAL YEAR 1986

BY BUREAU OF LAND MANAGEMENT

OREGON STATE OFFICE

FOR

U.S. FOREST SERVICE, WALLONA-WILTMAN NATIONAL FOREST

BAKER COUNTY, OREGON

ORIGINAL CORNER REMONUMENTED THIS SURVEY - 54 MONUMENTS SET

GROUP 1000, OREGON MONUMENTED BY LEONARD W. MURPHY

FILED 2-19-87

BAKER COUNTY SURVEYOR

SURVEY NO. 12-36-3