

CERTIFIED RECORD OF LAND CORNER MONUMENTATION


L-21

History of original corner establishment:

Corner established by Henry W. Cooke under Contract No. 427 and dated December 15, 1881.

Surveyor General records state:

Set a basalt stone 16 x 12 x 10 ins 11 ins in ground for 1/4 sec cor marked 1/4 on W face and raised a mound of stone alongside.

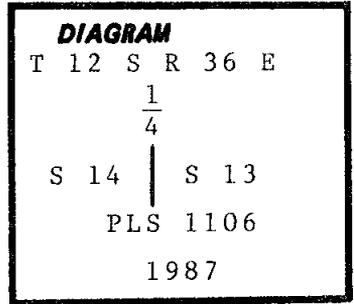

Description of corner evidence found:

Found basalt stone 15 x 11 x 9"(record, 16 x 12 x 10") firmly set, marked 1/4 on W face, small mound of stones westerly.

Description of monument and accessories I established to perpetuate the original location of this corner:

At position of found original stone...

Set 2 1/2" aluminum pipe with 2 1/2" aluminum cap 18" in the ground and surrounded with a mound of earth and stone. Cap marked as shown in corner diagram. Buried original stone alongside.

New bearing trees established:

A juniper 10" dia bears S41°W, 82.7' marked 1/4S14 BT.

A juniper 15" dia bears S15 1/2°E, 104.6' marked 1/4S13 BT.

New bearing trees have a brass washer stamped PLS 1106 nailed to face of blaze. Attached signs 54-3 & 54-9 and painted face of blaze and a 6" band of red around each BT. Set steel fence post South of corner and attached sign 54-9.

Compass declination 19° East.

I hereby certify that the above corner monument was properly re-established to U.S.F.S. standards under my supervision and witnessed by Scott Munro on May 19, 1987

**REGISTERED
PROFESSIONAL
LAND SURVEYOR**

William R. Wells

OREGON
JULY 22, 1977
WILLIAM R. WELLS
1106

Office of...County Surveyor..... County of...Baker.....
 State of...Oregon....., I hereby certify that the within instrument was filed in this office
 for record on the..... day of....., 19.....
 by
 (COUNTY OFFICIAL) (DEPUTY)

FILED 6-3-87
 BAKER COUNTY SURVEYOR
 SURVEY NO. 12-35-4