

CERTIFIED RECORD OF LAND CORNER MONUMENTATION


N-15

History of original corner establishment:

Corner established by Henry W. Cooke under Contract No. 427 and dated December 15, 1881.

Surveyor General records state:

Set a basalt stone 20 x 12 x 6 ins 11 ins in ground for 1/4 sec cor marked 1/4 on N face and raised a mound of stone alongside.

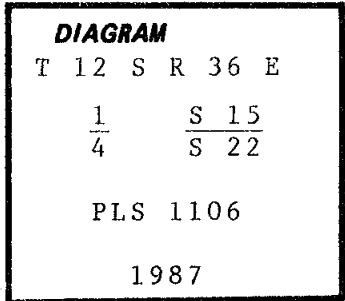

Description of corner evidence found:

Found basalt stone 20 x 12 x 6" lying on side marked 1/4, stone mound and fence corner West.

Description of monument and accessories I established to perpetuate the original location of this corner:

At position of found original stone...

Set 2½" aluminum pipe with 2½" aluminum cap 13" in the ground and surrounded with a mound of earth and stone. Cap marked as shown in corner diagram. Buried corner stone alongside.

New bearing trees established:

A p pine 9" dia bears N57 3/4° W, 73.5' marked 1/4 S15 BT.

A p pine 13" dia bears S15 1/4° W, 42.2' marked 1/4 S22 BT.

New bearing trees have a brass washer stamped PLS 1106 nailed to face of blaze. Attached signs 54-3 & 54-9 and painted face of blaze and a 6" band around each BT. Set steel fence post South of corner and attached sign 54-9.

Compass declination 19° East.

I hereby certify that the above corner monument was properly re-established to U.S.F.S. standards under my supervision and witnessed by Scott Munro on May 12, 1987.

REGISTERED PROFESSIONAL LAND SURVEYOR

William R. Wells

OREGON JULY 22, 1977 WILLIAM R. WELLS 1106

Office of..... County Surveyor..... County of..... Baker.....

State of..... Oregon....., I hereby certify that the within instrument was filed in this office

for record on the..... day of....., 19.....

..... by

(COUNTY OFFICIAL)

(DEPUTY)

FILED 6-3-87
BAKER COUNTY SURVEYOR
SURVEY NO. 12-36-5