

CERTIFIED RECORD OF LAND CORNER MONUMENTATION

N-17


History of original corner establishment:

Corner established by Henry W. Cooke under Contract No. 427 and dated December 15, 1881.

Surveyor General records state:

Set a basalt stone 16 x 14 x 14 ins 11 ins in ground for cor to secs 14, 15, 22 & 23 marked with 3 notches on S and 1 notch on E edges from which:

A pine 40" dia bears N70°W, 147 lks dist marked T12SR36ES15 BT.
A juniper 12" dia bears N85°E, 98 lks dist marked T12SR36ES14 BT.
No other trees within limits and raised a mound of stone alongside.

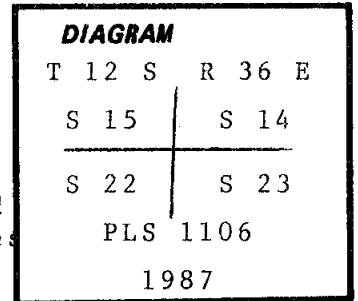

Description of corner evidence found:

Found basalt stone 16 x 12 x 7" (record 16 x 14 x 14") lying alongside stone mound with 2 notches on one edge. Stone mound Northerly of stone from which:

A p pine snag 37" dia bears N70 3/4°W (record N70°W), 97.1' with scribing visible on double blaze. A juniper 20" dia bears N85°E, 66.7' with scribing visible on double blaze.

Description of monument and accessories I established to perpetuate the original location of this corner:

At position of found original stone...

Set 2 1/2" aluminum pipe with 2 1/2" aluminum cap 6" in the ground and surrounded with a mound of earth and stone. Cap marked as shown in corner diagram. Buried corner stone alongside.

New bearing trees established:

A p pine 13" dia bears N60°W, 96.1' marked T12SR36ES15 BT.
A juniper 8" dia bears S41 1/4°E, 84.7' marked T12SR36ES23 BT.
A juniper 10" dia bears S45°W, 51.2' marked T12SR36ES22 BT.

New bearing trees have a brass washer stamped PLS 1106 nailed to face of blaze. Attached signs 54-3 & 54-9 and painted face of blaze and a 6" band around each BT. Set steel fence post South of corner and attached sign 54-9.

Compass declination 19° East.

I hereby certify that the above corner monument was properly re-established to U.S.F.S. standards under my supervision and witnessed by Scott Munro on May 12, 1987.

**REGISTERED
PROFESSIONAL
LAND SURVEYOR**

William R. Wells

OREGON
JULY 28, 1987
WILLIAM R. WELLS
1106

Office of..... County Surveyor..... County of..... Baker.....
State of..... Oregon....., I hereby certify that the within instrument was filed in this office
for record on the..... day of....., 19.....
..... by
(COUNTY OFFICIAL) (DEPUTY)

FILED 6-3-87
BAKER COUNTY SURVEYOR
SURVEY NO. 12-35-6