

CERTIFIED RECORD OF LAND CORNER MONUMENTATION


N-21

History of original corner establishment:

Corner established by Henry W. Cooke under Contract No. 427 and dated December 15, 1881.

Surveyor General records state:

Set a basalt stone 18 x 16 x 12 ins 12 ins in ground for cor to secs 13, 14, 23 & 24 marked with 3 notches on S and 1 notch on E edges and raised a mound of stone 2 ft high 4½ ft base alongside.

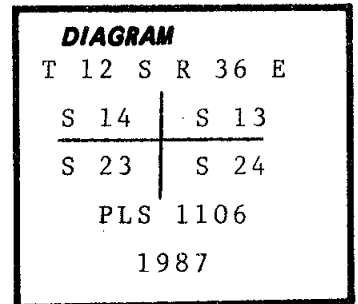

Description of corner evidence found:

Found basalt stone 15 x 11 x 10" (record, 18 x 16 x 12") with 3 notches on S face and 1 notch on E face, with a large stone mound west.

Description of monument and accessories established to perpetuate the original location of this corner:

At position of found original stone...

Set 2½" aluminum pipe with 2½" aluminum cap 16" in the ground and surrounded with a mound of earth and stone. Cap marked as shown in corner diagram. Buried original stone alongside.


New bearing trees established:

- A juniper 12" dia bears N77¼° E, 40.8' marked T12SR36ES13 BT.
- A juniper 9" dia bears S32¼° E, 125.3' marked T12SR36ES24 BT.
- A juniper 10" dia bears S66½° W, 90.0' marked T12SR36ES23 BT.
- A juniper 8" dia bears N74¼° W, 83.0' marked T12SR36ES14 BT.

New bearing trees have a brass washer stamped PLS 1106 nailed to face of blaze. Attached signs 54-3 & 54-9 and painted face of blaze and a 6" band of red around each BT. Set steel fence post West of corner and attached sign 54-9.

Compass declination 19° East.

I hereby certify that the above corner monument was properly re-established to U.S.F.S. standards under my supervision and witnessed by Scott Munro on May 21, 1987.

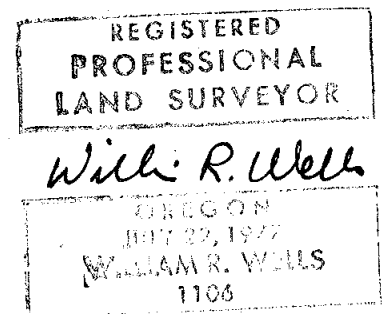

Office of County Surveyor..... County of... Baker.....
 State of Oregon....., I hereby certify that the within instrument was filed in this office
 for record on the..... day of....., 19.....
 by
 (COUNTY OFFICIAL) (DEPUTY)

FILED 6-3-87
 BAKER COUNTY SURVEYOR
 SURVEY NO. 12-36-7