

CERTIFIED RECORD OF LAND CORNER MONUMENTATION


N-23

History of original corner establishment:

Corner established by Henry W. Cooke under Contract No. 427 and dated December 15, 1881.

Surveyor General records state:

Set a basalt stone 16 x 14 x 12 ins 11 ins in ground for 1/4 sec cor marked 1/4 on N face and raised a mound of stone alongside.

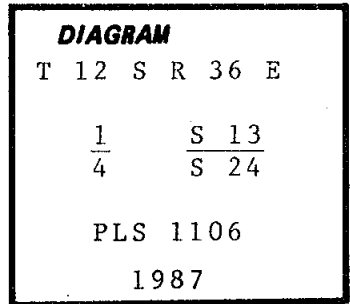

Description of corner evidence found:

Found a basalt stone 15 x 14 x 10" (record, 16 x 14 x 12") marked 1/4 with stone mound alongside to North.

Description of monument and accessories I established to perpetuate the original location of this corner:

At position of found original stone...

Set 2 1/2" aluminum pipe with 2 1/2" aluminum cap 15" in the ground and surrounded with a mound of earth and stone. Cap marked as shown in corner diagram. Buried original stone alongside.

New bearing trees established:

A juniper 9" dia bears N53 1/2° W, 46.2' marked 1/4 S13 BT.

A juniper 10" dia bears S38° W, 131.1' marked 1/4 S24 BT.

New bearing trees have a brass washer stamped PLS 1106 nailed to face of blaze. Attached signs 54-3 & 54-9 and painted face of blaze and a 6" band of red around each BT. Set steel fence post West of corner and attached sign 54-9.

Compass declination 19° East.

I hereby certify that the above corner monument was properly re-established to U.S.F.S. standards under my supervision and witnessed by Scott Munro on May 21, 1987.

REGISTERED PROFESSIONAL LAND SURVEYOR

William R. Wells

OREGON JULY 22, 1977 WILLIAM R. WELLS 1106

Office of..... County Surveyor..... County of..... Baker
Oregon
State of....., I hereby certify that the within instrument was filed in this office
for record on the..... day of....., 19.....

..... by
(COUNTY OFFICIAL) (DEPUTY)

FILED 6-3-87
BAKER COUNTY SURVEYOR
SURVEY NO. 12-38-8