

CERTIFIED RECORD OF LAND CORNER MONUMENTATION

P-17

History of original corner establishment:


Corner established by Henry W Cooke U.S. Deputy Surveyor under Contract No.427 dated December 15, 1881.

Surveyor General records state:

Set a basalt stone 16 x 14 x 9 ins 11 ins in ground for 1/4 sec cor marked 1/4 on W face from which:

A pine 12 ins diam bears S85°E, 178 lks dist marked 1/4S BT.

A pine 14 ins dia bears N70°W, 202 lks dist marked 1/4S BT.

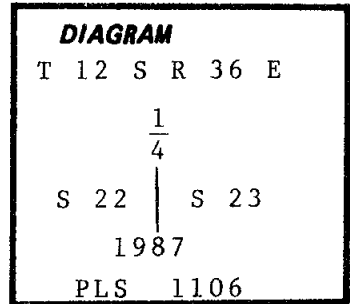

Description of corner evidence found:

Found a 14 x 13 x 7" (record states 16 x 14 x 9") basalt stone marked "4" on North side of a mound of stone from which:

A 27" p pine bears S75½°E (record states S85°E), 117.5' with healed blaze. A root hole with remains of cut up tree near bears N70°W, 133±' dist.

Description of monument and accessories I established to perpetuate the original location of this corner:

At position of found original stone... Set a 2½" x 30" aluminum pipe with 2½" aluminum cap 24" in the ground and surrounded with a mound of earth and stone. Cap marked as shown in diagram. Buried corner stone in mound. Original BT maintained to U.S.D.A.- Forest Service specifications.

New bearing tree established: A 11" p pine bears N7½°W, 28.6' scribed 1/4S22 BT.

New bearing trees have a brass washer stamped PLS 1106 nailed to face of blaze, attached signs 54-3 & 54-9 and painted face of blaze and a 6" red band around each BT. Set steel fence post South of corner and attached sign 54-9.

Compass declination 19° East.

I hereby certify that the above described corner monument was properly remonumented by me and witnessed by Bill Blanford on May 1, 1987.

REGISTERED
PROFESSIONAL
LAND SURVEYOR

William R. Wells

OREGON
JULY 22, 1977
WILLIAM R. WELLS
1106

Office of.....County Surveyor..... County of..... Baker
Oregon
State of....., I hereby certify that the within instrument was filed in this office
for record on the..... day of....., 19.....

..... by
(COUNTY OFFICIAL) (DEPUTY)

FILED 6-3-87
BAKER COUNTY SURVEYOR
SURVEY NO. 12-36-10