

CERTIFIED RECORD OF LAND CORNER MONUMENTATION


P-21

**History of original corner establishment:**

Corner established by Henry W. Cooke under Contract No. 427 and dated December 15, 1881.

Surveyor General records state:

Set a basalt stone 16 x 12 x 10 ins 11 ins in ground for 1/4 sec cor marked 1/4 on West face and raised a mound of stone alongside.

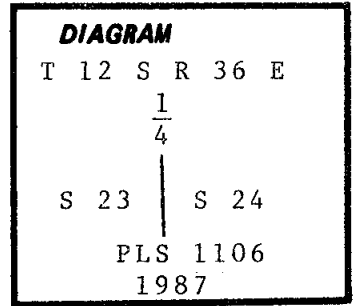

**Description of corner evidence found:**

Found a basalt stone 17 x 12 x 8" (record, 16 x 12 x 10") with faint marks possibly "4S" in scattered mound at fence corner.

**Description of monument and accessories established to perpetuate the original location of this corner:**

At position of found original stone...

Set 2 1/2" aluminum pipe with 2 1/2" aluminum cap 18" in the ground and surrounded with a mound of earth and stone. Cap marked as shown in corner diagram. Buried original stone alongside.

New bearing trees established:

A p pine 18" dia bears N19 1/4° W, 120.2' marked 1/4S23 BT.  
A p pine 21" dia bears N54 1/2° E, 145.7' marked 1/4S24 BT.

New bearing trees have a brass washer stamped PLS 1106 nailed to face of blaze. Attached signs 54-3 & 54-9 and painted face of blaze and a 6" band of red around each BT. Set steel fence post South of corner and attached sign 54-9.

Compass declination 19° East.

I hereby certify that the above corner monument was properly re-established to U.S.F.S. standards under my supervision and witnessed by Scott Munro on May 21, 1987.

REGISTERED  
PROFESSIONAL  
LAND SURVEYOR

*William R. Wells*

OREGON  
JULY 22, 1977  
WILLIAM R. WELLS  
1106

Office of..... County Surveyor..... County of..... Baker.....

State of..... Oregon....., I hereby certify that the within instrument was filed in this office for record on the..... day of....., 19.....

..... by .....  
(COUNTY OFFICIAL) (DEPUTY)

FILED 6-3-87

BAKER COUNTY SURVEYOR

SURVEY NO. 12-35-11