

CERTIFIED RECORD OF LAND CORNER MONUMENTATION


R-15

**History of original corner establishment:**

Corner established by Henry W. Cooke under Contract No. 427 and dated December 15, 1881.

Surveyor General records state:

Set a basalt stone 12 x 10 x 10 ins 8 ins in ground for 1/4 sec cor marked 1/4 on N face from which:  
A pine 14" dia bears S80°W, 11 lks dist marked 1/4S BT. A fir 14" dia bears N65°E, 62 lks dist marked 1/4S BT.

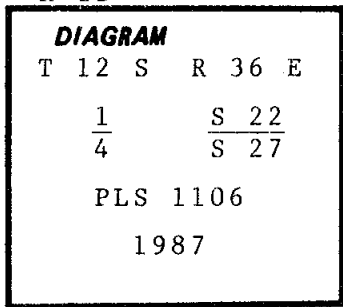

**Description of corner evidence found:**

Found a basalt stone 16 x 12 x 10" (record 12 x 10 x 10") firmly set marked 1/4 on N face, stone broken in half from which:

A p pine 17" dia bears S81 1/4°W (record S80°W), 7.1' with healed blaze. A fir 19" dia bears N50°E (record N65°E), 40.0', with visible scribing.

**Description of monument and accessories | established to perpetuate the original location of this corner:**

At position of found stone...

Set 2 1/2" aluminum pipe with 2 1/2" aluminum cap 8" in the ground and surrounded with a mound of earth and stone. Cap marked as shown in corner diagram. Buried corner stone alongside.

Attached to each original BT, signs 54-3 and 54-9 and painted blaze and 6" red band around each. Set steel fence post West of corner with sign 54-9.

Compass declination 19° East.

I hereby certify that the above corner monument was properly re-established to U.S.F.S. standards under my supervision and witnessed by Scott Munro on May 13, 1987.

REGISTERED  
PROFESSIONAL  
LAND SURVEYOR

*William R. Wells*

OREGON  
JULY 22, 1977  
WILLIAM R. WELLS  
1106

Office of..... County Surveyor..... County of..... Baker.....  
Oregon....., I hereby certify that the within instrument was filed in this office  
for record on the..... day of....., 19.....

..... by .....  
(COUNTY OFFICIAL) (DEPUTY)

FILED 6-3-87  
BAKER COUNTY SURVEYOR  
SURVEY NO. 12-36-13