

CERTIFIED RECORD OF LAND CORNER MONUMENTATION

R-17


History of original corner establishment:

Corner established by Henry W. Cooke under Contract No. 427 and dated December 15, 1881.

Surveyor General records state:

Set a basalt stone 16 x 14 x 10 ins 11 ins in ground for cor to secs 22, 23, 26 & 27 marked with 2 notches on S and 1 notch on E edges from which:

A pine 20" dia bears N8°E, 86 lks dist marked T12SR36ES23 BT. A pine 16" dia bears S17°E, 99 lks dist marked T12SR36ES26 A pine 24" dia bears S20°W, 119 lks dist marked T12SR36ES27 BT. A pine 24" dia bears N18°W, 83 lks dist marked T12SR36ES22 BT.

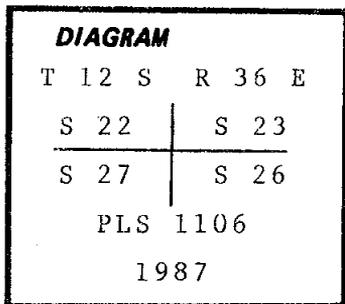

Description of corner evidence found:

No evidence of original corner stone.

Remains of S23 BT...rotted fragments with axe work N7°E(record N8°E), 57.0'. A p pine 24" dia bears S16°E(record S17°E), 65.3' with scribing visible. A p pine 31" dia bears S18°W(record S20°W), 78.5' with scribing visible. Remains of BT stump size indeterminable with fragmentary scribing bears N16½°W(record N18°W), 53.6'.

Description of monument and accessories I established to perpetuate the original location of this corner:

At position re-established from remaining original BTs...

Set 2½" aluminum pipe with 2½" aluminum cap 13" in the ground and surrounded with a mound of earth and stone. Cap marked as shown in corner diagram.

New bearing trees established:

A p pine 12" dia bears N24°W, 55.9' marked T12SR36ES22 BT.
A p pine 13" dia bears N14½°E, 24.9' marked T12SR36ES23 BT.

New bearing trees have a brass washer stamped PLS 1106 nailed to face of blaze. Attached signs 54-3 & 54-9 and painted face of blaze and a 6" band around each BT. Set steel fence post South of corner and attached sign 54-9.

Compass declination 19° East.

I hereby certify that the above corner monument was properly re-established to U.S.F.S. standards under my supervision and witnessed by Scott Munro on May 13, 1987.

**REGISTERED
PROFESSIONAL
LAND SURVEYOR**

William R. Wells

OREGON
JULY 22, 1977
WILLIAM R. WELLS
1106

Office of.....County.....Surveyor..... County of.....Baker.....

State of.....Oregon..... I hereby certify that the within instrument was filed in this office

for record on the..... day of....., 19.....

..... by

(COUNTY OFFICIAL)

(DEPUTY)

FILED 6-3-87
BAKER COUNTY SURVEYOR
SURVEY NO. 12-36-14