

CERTIFIED RECORD OF LAND CORNER MONUMENTATION


R-21

History of original corner establishment:

Corner established by Henry W Cooke U.S. Deputy Surveyor under Contract No.427 dated December 15, 1881.

Surveyor General records state:

Set a basalt stone 16 x 16 x 12 ins 11 ins in ground for cor to secs 23, 24, 25 & 26 marked with 2 notches on S and 1 notch on East edges and raised a mound of stone 2 ft high 4½ ft base alongside.

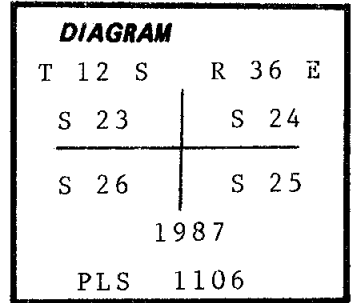

Description of corner evidence found:

Found a 14 x 14 x 9"(record states 16 x 16 x 12") basalt stone in center of stone mound marked with 2 notches S & 1 on Northeast side.

NOTE: Mitchell has a location poster on tree referencing rock in place about N20°E, 75' from true corner.

Description of monument and accessories established to perpetuate the original location of this corner:

At position of found original stone...

Set a 2½" x 30" aluminum pipe with 2½" aluminum cap 24" in the ground and surrounded with a mound of earth and stone. Cap marked as shown in diagram. Buried corner stone in mound.

New bearing trees established:

A 8" juniper bears N40½°E, 58.0' scribed T12SR36ES24 BT.

A 10" p pine bears S38½°E, 67.7' scribed T12SR36ES25 BT.

A 10" north stem of double juniper bears S75°W, 95.0' scribed T12SR36ES26 BT.

A 14" p pine bears N86°W, 49.4' scribed T12SR36ES23 BT.

New bearing trees have a brass washer stamped PLS 1106 nailed to face of blaze, attached signs 54-3 & 54-9 and painted face of blaze and a 6" red band around each BT. Set steel fence post North of corner and attached sign 54-9.

Compass declination 19° East.

I hereby certify that the above described corner monument was properly remonumented by me and witnessed by Bill Blanford on May 1, 1987.

| |
|---|
| REGISTERED PROFESSIONAL LAND SURVEYOR |
|---|

William R. Wells

| |
|---|
| OREGON JULY 22, 1977 WILLIAM R. WELLS 1106 |
|---|

Office of.....County Surveyor..... County of..... Baker
 State of..... Oregon....., I hereby certify that the within instrument was filed in this office
 for record on the..... day of....., 19.....
 by
 (COUNTY OFFICIAL) (DEPUTY)

FILED 6-3-87
 BAKER COUNTY SURVEYOR
 SURVEY NO. 12-36-15