

CERTIFIED RECORD OF LAND CORNER MONUMENTATION

T-17


History of original corner establishment:

Corner established by Henry W. Cooke under Contract No. 427 and dated December 15, 1881.

Surveyor General records state:

Set a basalt stone 16 x 12 x 8 ins 11 ins in ground for 1/4 sec cor marked 1/4 on W face from which:

A pine 30" dia bears S80°W, 133 lks dist marked 1/4 S BT.
A pine 15" dia bears N40°E, 74 lks dist marked 1/4 S BT.

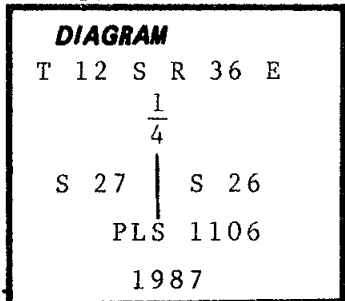

Description of corner evidence found:

Found a basalt stone 13 x 11 x 10" (record, 16 x 12 x 8") with "4" visible in a stone mound from which:

A p pine 36" dia bears N40°E, 47.9' with scribing visible on charred blaze.

A p pine snag 28" dia bears S80°W, 87.8' with scribing visible on charred blaze.

Description of monument and accessories I established to perpetuate the original location of this corner:

At position of found original stone...

Set 2 1/2" aluminum pipe with 2 1/2" aluminum cap 13" in the ground and surrounded with a mound of earth and stone. Cap marked as shown in corner diagram. Buried original stone alongside.

New bearing tree established:

A p pine 12" dia bears N80 1/4°W, 56.7' marked 1/4 S 27 BT.

New bearing trees have a brass washer stamped PLS 1106 nailed to face of blaze. Attached signs 54-3 & 54-9 and painted face of blaze and a 6" band of red around each BT. Set steel fence post East of corner and attached sign 54-9.

Compass declination 19° East.

I hereby certify that the above corner monument was properly re-established to U.S.F.S. standards under my supervision and witnessed by Scott Munro on May 22, 1987.

REGISTERED
 PROFESSIONAL
 LAND SURVEYOR

William R. Wells

OREGON
 JULY 22, 1977
 WILLIAM R. WELLS
 1106

Office of County Surveyor County of Baker

State of Oregon, I hereby certify that the within instrument was filed in this office for record on the day of, 19.....

..... by

(COUNTY OFFICIAL) (DEPUTY)

FILED 6-5-87

BAKER COUNTY SURVEYOR

SURVEY NO. 12-36-16