

CERTIFIED RECORD OF LAND CORNER MONUMENTATION


T-21

History of original corner establishment:

Corner established by Henry W. Cooke under Contract No. 427 and dated December 15, 1881.

Surveyor General records state:

Set a basalt stone 18 x 14 x 10 ins 12 ins in ground for 1/4 sec cor marked 1/4 on W face, dug pits 18 x 18 x 12 ins N & S of cor 5 1/2 ft dist and raised a mound of earth 2 ft high 4 ft base alongside.

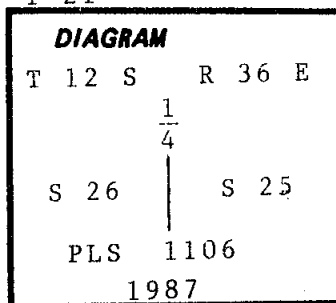

Description of corner evidence found:

Found basalt stone 20 x 12 x 7 (record states 18 x 14 x 10") with chisel marks which are illegible.

Description of monument and accessories established to perpetuate the original location of this corner:

At position of found stone.....

Set 2 1/2" aluminum pipe with 2 1/2" aluminum cap 22" in the ground and surrounded with a mound of earth and stone. Cap marked as shown in corner diagram. Buried corner stone alongside.

New bearing trees established:

- A p pine 13" dia bears S46 1/2° W, 39.9' marked 1/4 S26 BT.
- A juniper 8" dia bears S76° E, 44.1' marked 1/4 S25 BT.

New bearing trees have a brass washer stamped PLS 1106 nailed to face of blaze. Attached signs 54-3 & 54-9 and painted face of blaze and a 6" band around each BT. Set steel fence post West of corner and attached sign 54-9.

Compass declination 19° East.

I hereby certify that the above corner monument was properly re-established to U.S.F.S. standards under my supervision and witnessed by Scott Munro on May 15, 1987.

**REGISTERED
PROFESSIONAL
LAND SURVEYOR**

William R. Wells

OREGON
JULY 22, 1977
WILLIAM R. WELLS
1106

Office of.....County Surveyor..... County of..... Baker
 State of..... Oregon....., I hereby certify that the within instrument was filed in this office
 for record on the..... day of....., 19.....
 by
 (COUNTY OFFICIAL) (DEPUTY)

FILED 6-3-87
 BAKER COUNTY SURVEYOR
 SURVEY NO. 12-36-17