

CERTIFIED RECORD OF LAND CORNER MONUMENTATION

V-15


History of original corner establishment:

Corner established by Henry W Cooke U.S. Deputy Surveyor under Contract No.427 dated December 15, 1881.

Surveyor General records state:

Set a basalt stone 20 x 20 x 3 ins 15 ins in ground for 1/4 sec cor marked 1/4 on N face from which:

A pine 20 ins dia bears N80°W, 15 lks dist marked 1/4S BT.
A pine 24 ins dia bears S70°W, 63 lks dist marked 1/4S BT.

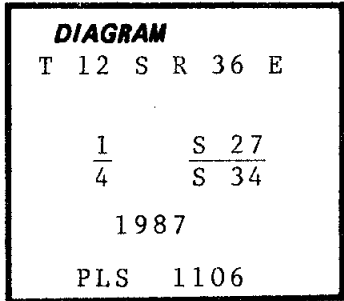

Description of corner evidence found:

A 18 x 23 x 4" basalt stone in small stone mound. (Could not make out marks on cor stone. Record states 20 x 20 x 3".)

A 16" p pine bears N65°W (record states N80°W), 9.9' with visible scribing on double blaze.

A 23" p pine snag bears S42°W (record states S70°W), 41.6' with visible scribing on double blaze.

Description of monument and accessories established to perpetuate the original location of this corner:

At position of found original stone...

Set a 2½" x 30" aluminum pipe with 2½" aluminum cap 18" to bedrock in ground and surrounded with mound of earth and stone. Cap marked as shown in diagram. Buried corner stone in mound.

New bearing trees established from new monument:

A 6" juniper bears N48½°W, 91.7' scribed 1/4S27 BT.

A 6" p pine bears S16½°W, 55.6' scribed 1/4S34 BT.

New bearing trees have a brass washer stamped PLS 1106 nailed to face of blaze, attached signs 54-3 & 54-9 and painted face of blaze and a 6" red band around each BT. Set steel fence post West of corner and attached sign 54-9.

Compass declination 19° East.

I hereby certify that the above described corner monument was properly remonumented by me and witnessed by Bill Blanford on May 1, 1987.

REGISTERED PROFESSIONAL LAND SURVEYOR
--

William P. Wells

OREGON JULY 22, 1977 WILLIAM P. WELLS 1106

Office of.....County Surveyor..... County of.....Baker.....
State of.....Oregon....., I hereby certify that the within instrument was filed in this office
for record on the..... day of....., 19.....

..... by
(COUNTY OFFICIAL) (DEPUTY)